

Granville - Vance District Health Department
Environmental Health

Pin 08790029083

Permit Number 6453

☒ Improvement Permit

☒ Construction Authorization

Final Sketch

Fidelis Construction

Applicants Name

SADDLERIDGE - LOT 29

Subdivision - Section - Lot

Physical Address: 1096 Buggylene

TRUWORKS

System Installer

1-20-2015

Date

System design and details as installed.

Septic Tank Information:

Date: 6-8-14

Manufacture: DB-1000

ID #: STB-646

Pump Tank Information:

Date: /

Manufacturer: /

ID #: /

Distribution Box ☒

Pressure Manifold /

Serial Distribution /

Pump Info: /

Type of Facility: Residence

Number of Bedrooms: 3

Type of System: ☒ Gravity / Pump / Gravel / Polystyrene /

Well Drilled at time of inspection: Y or N

Well Info: Date drilled: /

Driller Name: /

Pump Depth: /


Pump HP: /

Depth: /

GPM: /

Casing: /

Installer Name: /

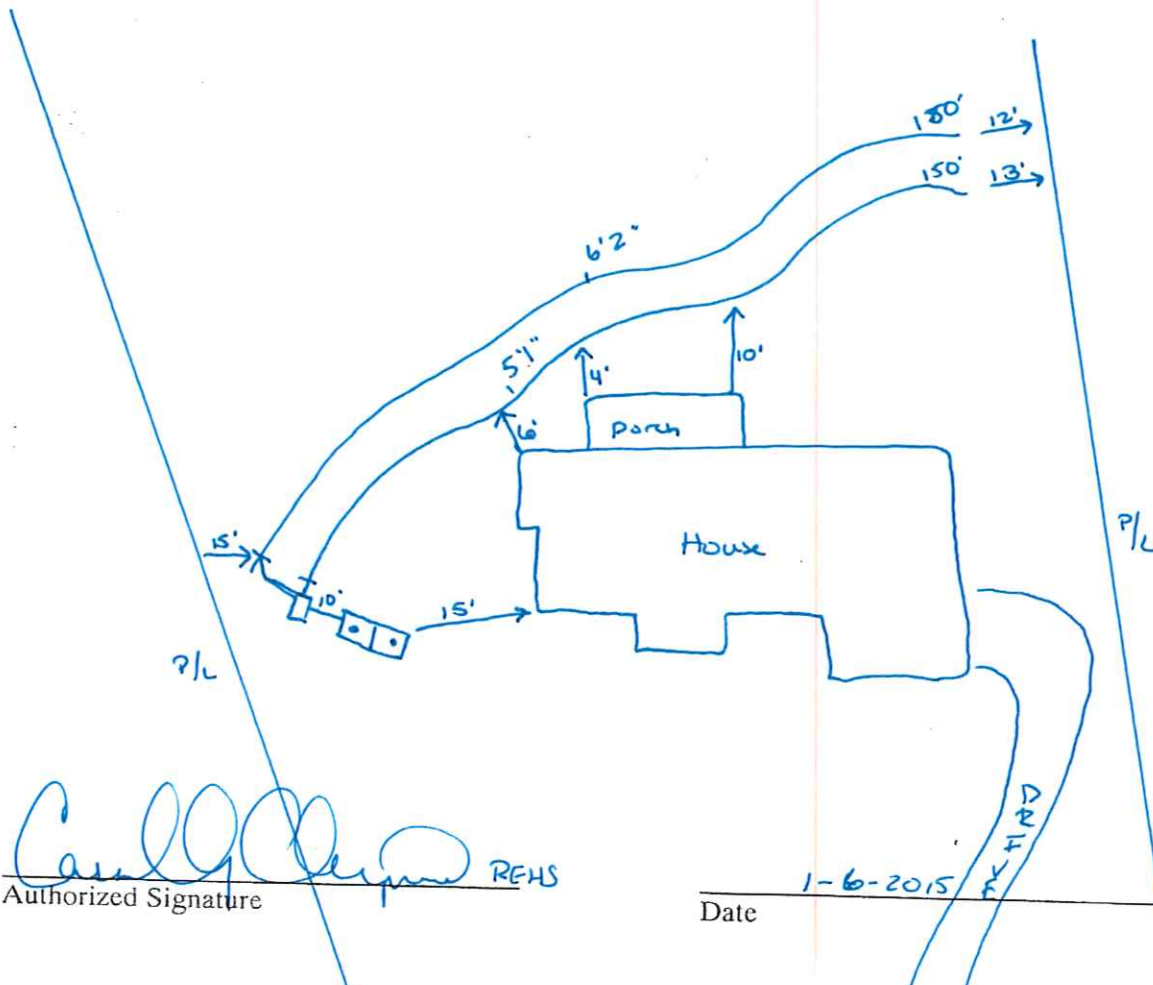

Authorized Signature

Date