


NOTE: Make sketch of installation showing location of house, septic tanks, privies, water supplies on adjacent property, etc. Write in measurements in order that installations may be located at later date.

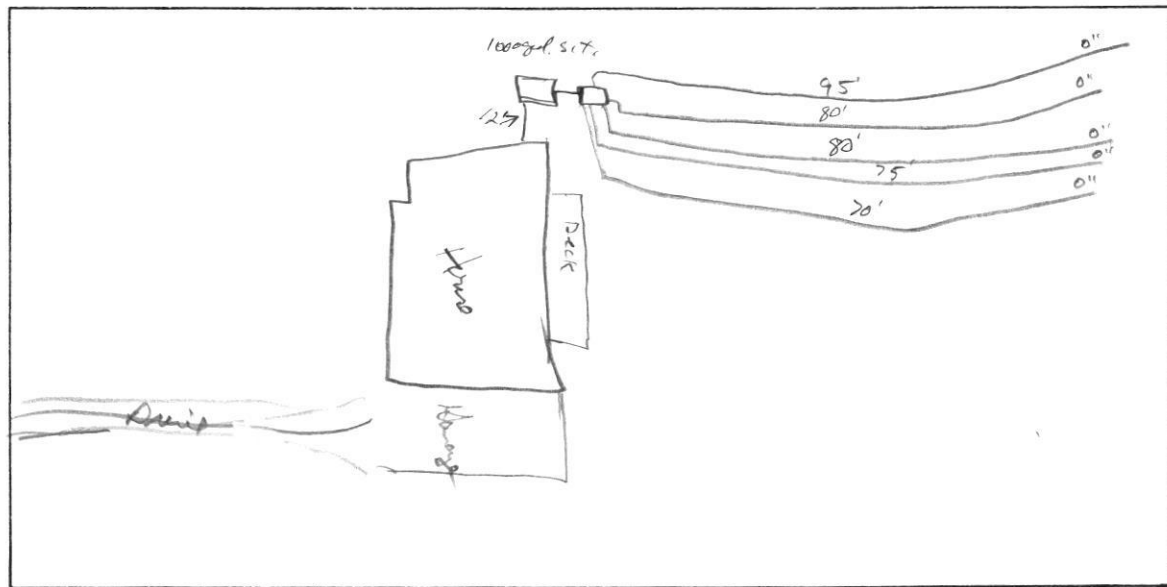

GRANVILLE-VANCE HEALTH DEPARTMENT—Sewage Disposal Record

Owner or Contractor Downey Homes Inc Date 1-26-07 S.R. No. 1714
 Location/Address Canterbury Ct.
 Subdivision/Mobile Home Park Name Menweather Lot Size _____
 Permit No. # 6009 Lot No. 4

New System ☒ Repair _____
 House ☒ Mobile Home _____ Business _____
 No. Bedrooms 4 No. People _____ No. Toilets _____
 Water Supply: Private _____ Approved _____
 Semi-Public _____ Unapproved _____
 Public _____ None _____

Nitrification System:

Tank Size 1000 gal.
 Distribution Box ☒ No. Lines 5
 Nitrification Field _____ Sq. Ft.

Lines:	1	2	3	4	5	6
Width	<u>3'</u>	<u>3'</u>	<u>3'</u>	<u>3'</u>	<u>3'</u>	
Length	<u>95'</u>	<u>80'</u>	<u>80'</u>	<u>75'</u>	<u>70'</u>	
Grade	<u>0"</u>	<u>0"</u>	<u>0"</u>	<u>0"</u>	<u>0"</u>	
Stone Depth	<u>E-2</u>	<u>Flow</u>				

Layout to be followed by installer:

Improvements Permit By Jimmy B. Clafford Installer Rabert Blackley
 Certificate of Completion By Jimmy B. Clafford Date of Inspection 1-26-07

* Construction must comply with all other applicable state and local regulations, but the permit is not a guarantee that the system will not malfunction and the Granville-Vance Health District will not be held responsible for a malfunctioning system.