



OPERATION PERMIT

Franklin County Health Department
107 Industrial Drive
Louisburg, NC 27549
Phone: _____

For Office Use Only

*CDP File Number 404525 - 1
County ID Number: _____
Evaluated For: NEW

Applicant: Cameron Gilliam

Property Owner: _____

Owner Address: _____

City: _____

State/Zip: /

Phone #: _____

Address: 95 LEISURE LN
LOUISBURG, NC 27549

Road #: _____

Township: _____

Subdivision: _____

Phase : NEW Lot: _____

Structure: SINGLE FAMILY

of Bedrooms: 3

of People: 3

Water Supply: NEW WELL

Saprolite System?: ☐ Yes ☒ No

Pump Required?: ☐ Yes ☒ No

Design Flow: 360

System Classification/Description: TYPE III B. SYSTEM
W/SINGLE EFFLUENT PUMP

Installer: Dickerson Backhoe

Certification #: 3711

Specific System POLYSTYRENE AGGREGATE
Installed: _____

STB: _____

PT: _____

Comments: 260' EZ FLOW INSTALLED

Septic Tank Date: _____

Pump Tank Date: _____

This system has been installed in compliance with applicable NC General Statutes, Rules for Sewage Treatment and Disposal, and all conditions of the Improvement Permit and Construction Authorization.

PERMIT CONDITIONS:

I. Performance: System shall perform in accordance with Rule .1301.

II. Monitoring: As required by Rule .1301.

III. Maintenance: Ground absorption sewage treatment and disposal systems shall be checked, and the contents of the septic tank removed, periodically from all compartments, to ensure proper operation of the system. The contents shall be pumped whenever the solids level is found to be more than 1/3 of the liquid depth in any compartment.

Other: _____

Subsurface Operator Required: ☐ Yes ☒ No

If yes, see attached sheet for additional operation conditions, maintenance and reporting.

Operation: _____

Other: 260' EZ FLOW INSTALLED

Authorized State Agent: Ennis, Crystal

Date of Issue: 10/23/2024

Owner/Applicant: _____

File # 404525 PIN# _____

Property Address: 95 Leisure Ln

Applicant or Owner Name: Cameron Gilliam

Environmental Health Septic/Well Permit Diagram

Building permits cannot be issued nor should construction begin without Construction Authorization issuance.

☒ Septic Improvement Permit
 ☒ Septic Construction Authorization (CA)
 ☒ CA Reissue**
 ☒ As Built
 ☒ Well Construction Authorization
 ☒ Additional Diagram/Specifications Attached


Diagram Date**: 2-8-24 EHS: Cristal Eric

**Any previously dated CA diagram is revoked and/or invalid. Confirm this is the valid diagram for the site before beginning any construction.

Installation/grouting inspections may be scheduled the day before, or, the day of installation until 9am by contacting the Environmental Health office at 919 496 8100. A revisit fee may apply if installation is not ready for inspection at the time requested. Septic Operations Permits will be issued after installation is approved, all permits conditions are met, and any outstanding fees are paid. Well Certificate of Completion will be issued after well head approval, all permit conditions are met, and any outstanding fees are paid.

Septic Tank 1000 Pump Tank 1000 Drainfield 3'x260' Type System Pto Acc Max Trench Depth 15"
 Septic Contractor Travis Kemp Dickerson Backhoe PT Graystone 1000 Septic/Pump tank dates 6/2/24 Pump fee? Yes No 50.00 10/22
 Well Contractor _____ Well Grout date: _____ Drawing not to scale

Vid tank, pump, float,
 alarm, & d-box
 7-16-24
 URF
 need to pay pump fee

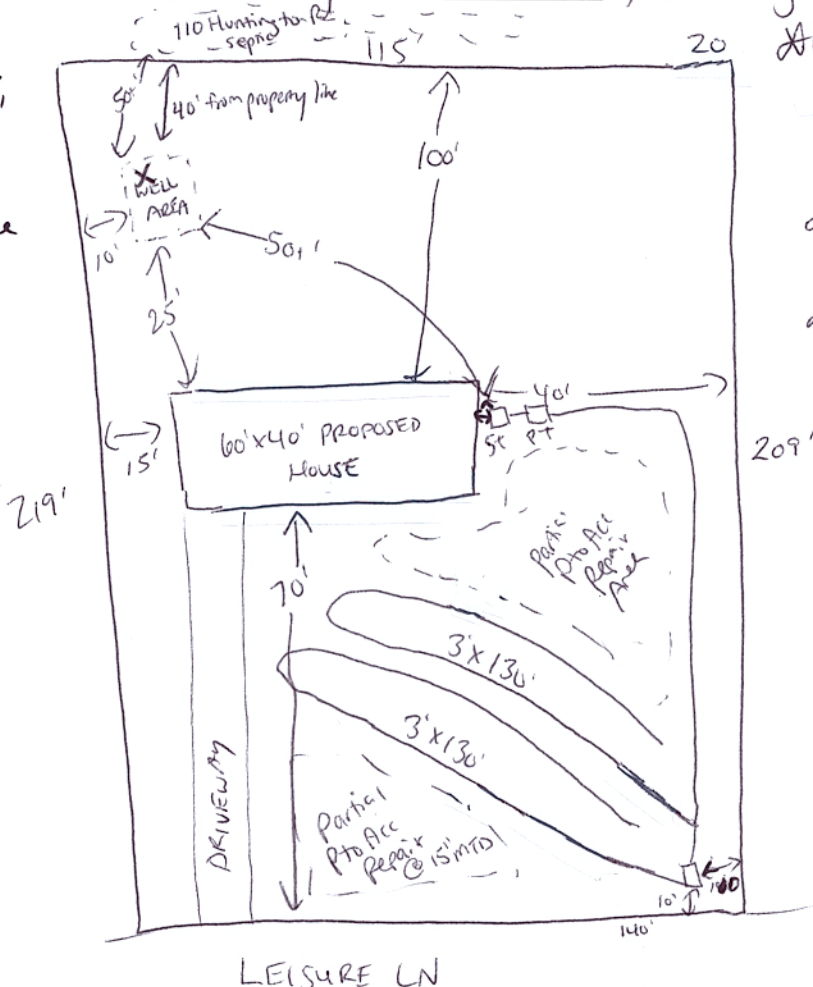

* Keep driveway as close to left property line as possible
 Do not park or drive over any part of septic system
 * Must bring in 6-8 inches approved soil cover
 * May have pits evaluated for a deeper trench depth (sagrolite)
 * Pump to D-Box