

GRANVILLE-VANCE HEALTH DEPARTMENT—Sewage Disposal Record

Owner or Contractor Chadner Homes Date 6-14-07 S.R. No. 1714

Location/Address Kroger Place off Bruce Gekko Rd.

Subdivision/Mobile Home Park Name Hawthorne Lot Size 1.0815 acres

Permit No. # 06175 Lot No. 39

New System ☒ Repair _____

House ☒ Mobile Home _____ Business _____

No. Bedrooms 4 No. People _____ No. Toilets _____

Water Supply: Private ☒ Approved _____

Semi-Public _____ Unapproved _____

Public _____ None _____

Nitrification System: _____

Tank Size 1000 gal. pump tank

Distribution Box 1 No. Lines 5

Nitrification Field 1714 Sq. Ft. _____

Lines: 1 1 2 2 3 3 4 3 5 3 6 3

Width 3' 3' 3' 3' 3' 3'

Length 36' 40' 60' 80' 100' 120'

Grade 0' 0' 0' 0' 0' 0'

Stone Depth 3' 4' 6' 8' 10' 12'

E2 Flow unit


Layout to be followed by installer:

Improvements Permit By David Tucker Installer Quality Landscapes Inc

Certificate of Completion By Eddie Yeart Date of Inspection 6-14-07

* Construction must comply with all other applicable state and local regulations, but the permit is not a guarantee that the system will not malfunction and the Granville-Vance Health District will not be held responsible for a malfunctioning system.

NOTE: Make sketch of installation showing location of house, septic tanks, privies, water supplies on adjacent property, etc. Write in measurements in order that installations may be located at later date.

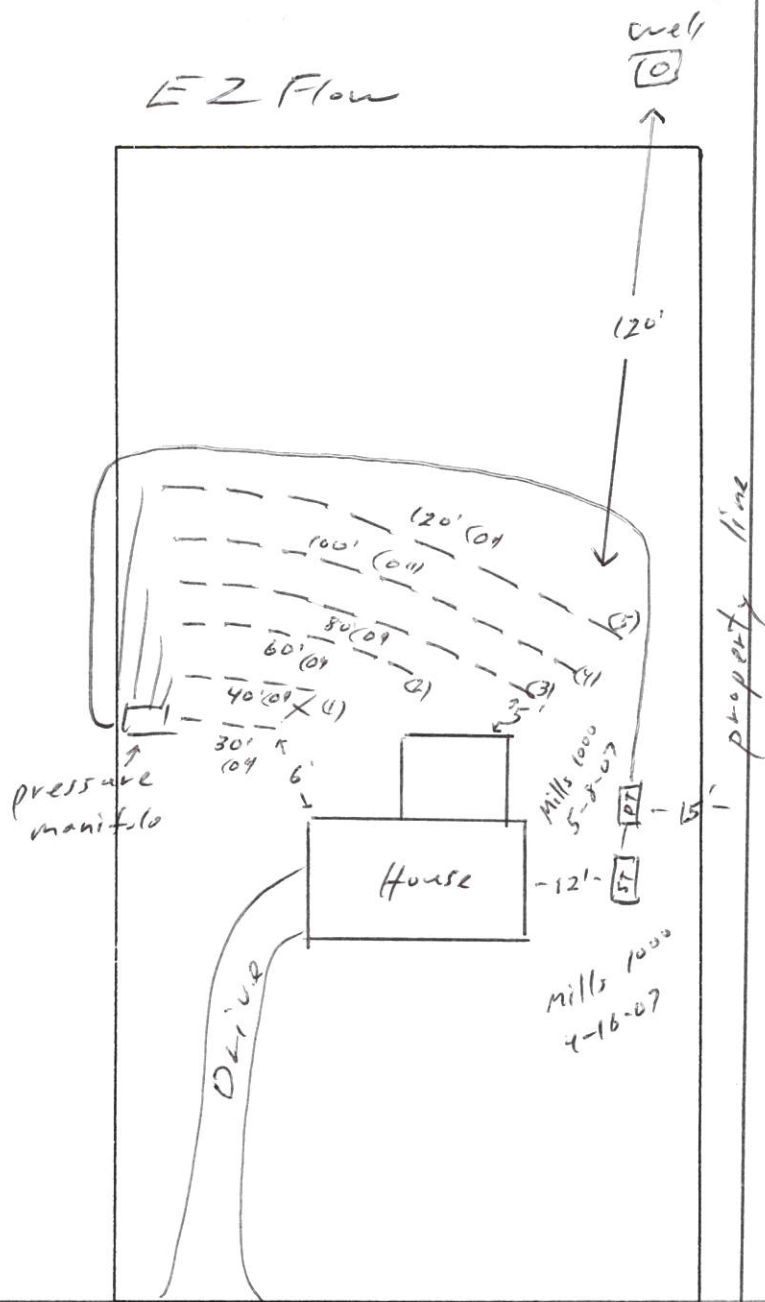

Kroger Place

Bruce Garner Road S.R. 1711