


NOTE: Make sketch of installation showing location of house, septic tanks, privies, water supplies on adjacent property, etc. Write in measurements in order that installations may be located at later date.

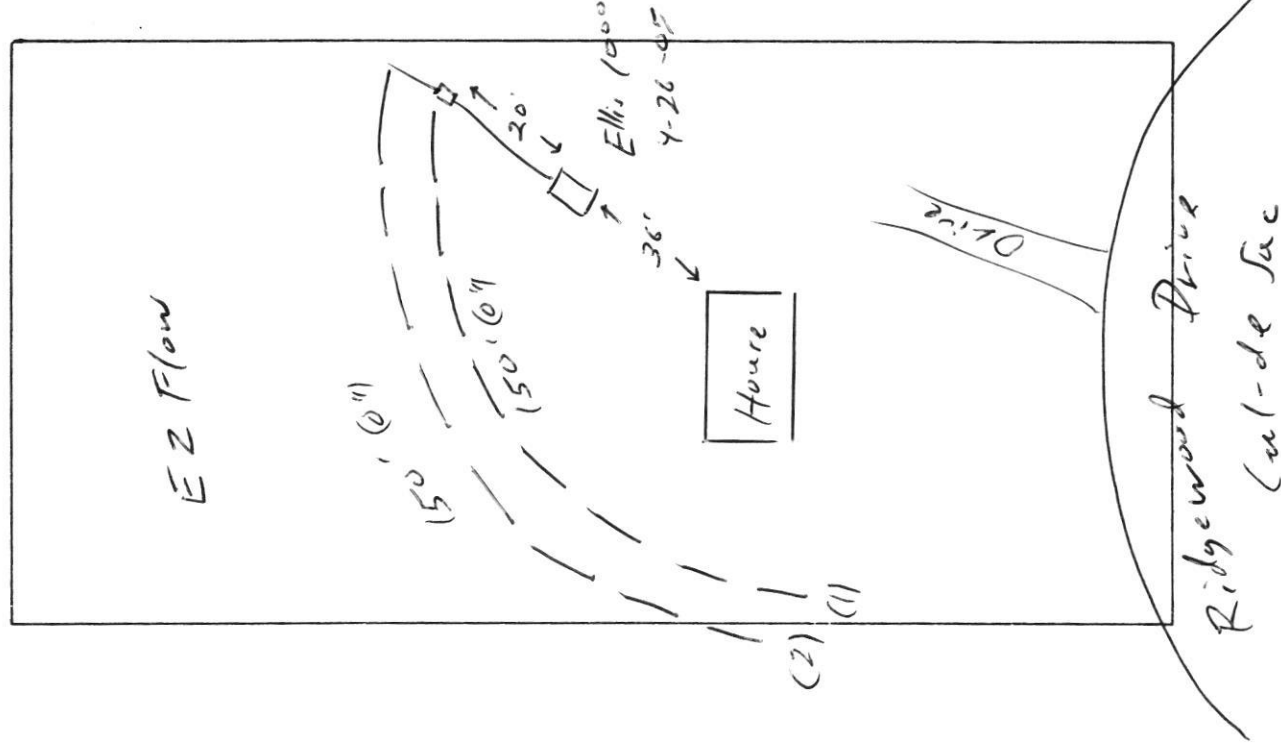

GRANVILLE-VANCE HEALTH DEPARTMENT—Sewage Disposal Record

Owner or Contractor Wynn Construction Date 9-1-05 S.R. No. 1622

Location/Address Ridgewood Drive

Subdivision/Mobile Home Park Name Ridgewood Lot Size 2.259 ac ±

Permit No. # 05075 Lot No. 11

New System ☒ Repair ☐

House ☒ Mobile Home ☐ Business ☐

No. Bedrooms 3 No. People No. Toilets

Water Supply: Private ☒ Approved ☐

Semi-Public ☐ Unapproved ☐

Public ☐ None ☐

Nitrification System:

Tank Size 1000 gal.

Distribution Box ☒ No. Lines 2

Nitrification Field 1200 Sq. Ft.

Lines:

	1	2	3	4	5	6
Width	<u>3'</u>	<u>3'</u>	<u> </u>	<u> </u>	<u> </u>	<u> </u>
Length	<u>150'</u>	<u>150'</u>	<u> </u>	<u> </u>	<u> </u>	<u> </u>
Grade	<u>0"</u>	<u>0"</u>	<u> </u>	<u> </u>	<u> </u>	<u> </u>
Stone Depth	<u>15</u>	<u>15</u>	<u> </u>	<u> </u>	<u> </u>	<u> </u>

Width 3' 3'

Length 150' 150'

Grade 0" 0"

Stone Depth 15 15

E 2 Flow unit

Layout to be followed by installer:

Improvements Permit By Eddie Yount Installer Robert Blackley

Certificate of Completion By Eddie Yount Date of Inspection 9-1-05

* Construction must comply with all other applicable state and local regulations, but the permit is not a guarantee that the system will not malfunction and the Granville-Vance Health District will not be held responsible for a malfunctioning system.