


CONTRACTOR James Bailey TANK MANU Mills 1000 MANU DATE 1-20-06
WELL INSTALLED YES _____ NO ☒ SYSTEM CODE EZ1203T-N-3

SEPTIC SYSTEM LAYOUT
(SKETCH SYSTEM LAYOUT HERE)

4 lines ~ 70' each

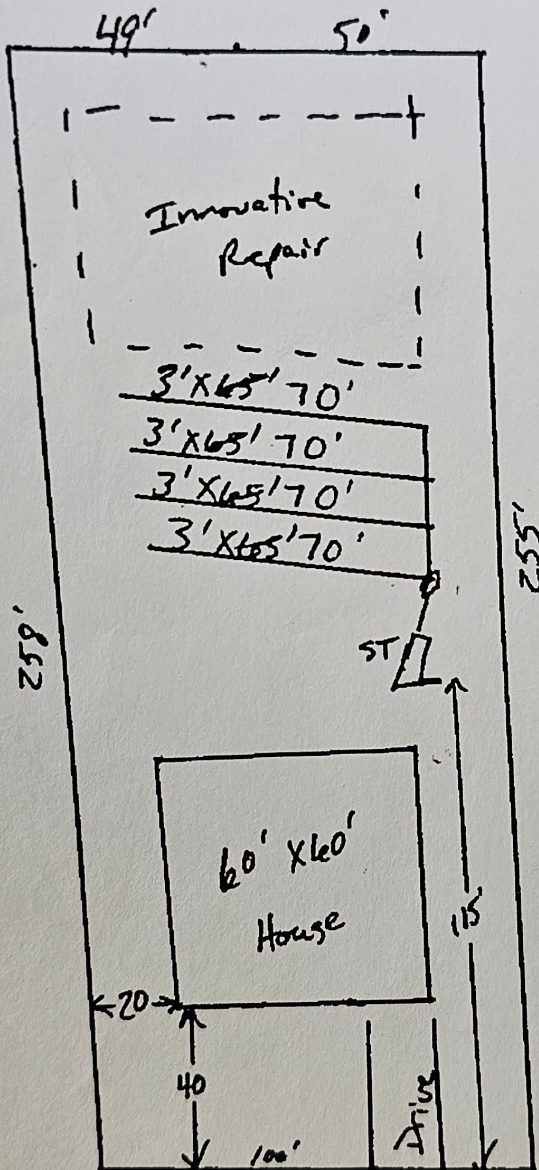

-Drawing not to scale
-Maintain proper setbacks
from foundation drains!!

Glen Oaks Drive

SEPTIC SYSTEM AS-BUILT
(IF DIFFERENT FROM INITIAL LAYOUT)
ON REVERSE

OPERATIONS PERMIT

DATE 3-24-06 EHS

Renee Shearin