



OPERATION PERMIT

Franklin County Health Department
107 Industrial Drive
Louisburg, NC 27549
Phone:

For Office Use Only

*CDP File Number 360353 - 1

County ID Number: 1845-37-0820

Evaluated For: NEW

Property Owner: DENISE PEARCE

Address: 742 MCKNIGHT DR. SUITE 213

Road #:

City: KNIGHTDALE

State/Zip: NC/ 27545

Phone #:

Township:

Subdivision: WOODLAND PARK

Phase : NEW

Lot: 52

Structure: SINGLE FAMILY

of Bedrooms: 3

of People: 4

Water Supply: NEW WELL

Saprolite System?: ☐ Yes ☒ No

Pump Required?: ☐ Yes ☒ No

Design Flow: 360

System Classification/Description: TYPE III B. SYSTEM
W/SINGLE EFFLUENT PUMP

Installer: DBS

Specific System EZFLOW EZ 1203H-GEO

Installed:

STB: 502

PT: 237

Comments:

Certification #:

Septic Tank Date: 11/04/2021

Pump Tank Date: 10/15/2021

This system has been installed in compliance with applicable NC General Statutes, Rules for Sewage Treatment and Disposal, and all conditions of the Improvement Permit and Construction Authorization.

PERMIT CONDITIONS:

I. Performance: System shall perform in accordance with Rule .1961.

II. Monitoring: As required by Rule .1961.

III. Maintenance: Ground absorption sewage treatment and disposal systems shall be checked, and the contents of the septic tank removed, periodically from all compartments, to ensure proper operation of the system. The contents shall be pumped whenever the solids level is found to be more than 1/3 of the liquid depth in any compartment.

Other:

Subsurface Operator Required: ☐ Yes ☒ No

If yes, see attached sheet for additional operation conditions, maintenance and reporting.

Operation:

Other:

Authorized State Agent: Jones, Lori

Date of Issue: 03/03/2022

Owner/Applicant: _____

Well Head 3-2-22

11:00 Septic

File # 360353 PIN# 1845-37-0820Property Address: 265 Sorrel Drive (Lot 52)Applicant or Owner Name: Denise Pearce

Environmental Health Septic/Well Permit Diagram

Building permits cannot be issued nor should construction begin without Construction Authorization issuance.

☒ Septic Improvement Permit ☒ Septic Construction Authorization (CA) ☐ CA Reissue** ☐ As Built
☒ Well Construction Authorization ☐ Additional Diagram/Specifications Attached

Diagram Date**: 8-5-21 EHS: Cynthia Evin


**Any previously dated CA diagram is revoked and/or invalid. Confirm this is the valid diagram for the site before beginning any construction.

Installation/grouting inspections may be scheduled the day before, or, the day of installation until 9am by contacting the Environmental Health office at 919 496 8100. A revisit fee may apply if installation is not ready for inspection at the time requested. Septic Operations Permits will be issued after installation is approved, all permits conditions are met, and any outstanding fees are paid. Well Certificate of Completion will be issued after well head approval, all permit conditions are met, and any outstanding fees are paid.

Septic Tank 1000 Pump Tank 1000 Drainfield 3'x300' Type System PtA Acc Max Trench Depth 26"
 Septic Contractor DBS Septic/Pump tank dates 11-4-2021 Pump fee? NO YES pd 50.00 (HH)

Well Contractor Upfront Well Grout date: *Drawing not to scale
 Well Head Final by log 12-7-2021 ✓ Elevation: 2 bottom lines *Pump fee due

Tank Pump
 DB1000 DBPT 237/1000 SJE Panel ✓ Rope
 STB 502 Water ✓ # 712261X - 21312
 Alarm ✓ 120V
 Switch ✓ 349' Champion S

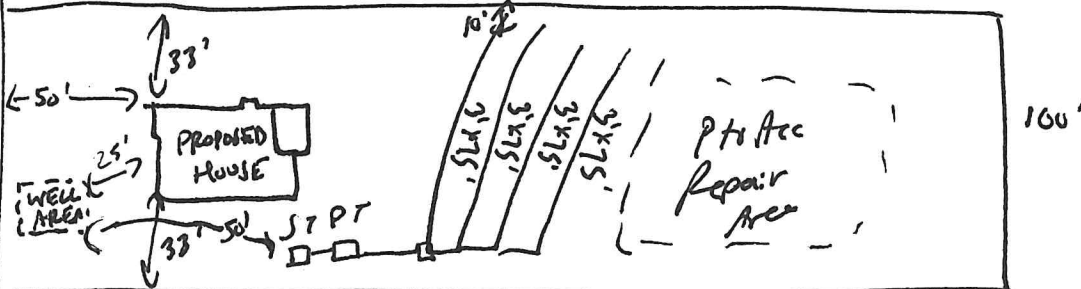

Installed 350' As Designed