


NOTE: Make sketch of installation showing location of house, septic tanks, privies, water supplies on adjacent property, etc. Write in measurements in order that installations may be located at later date.

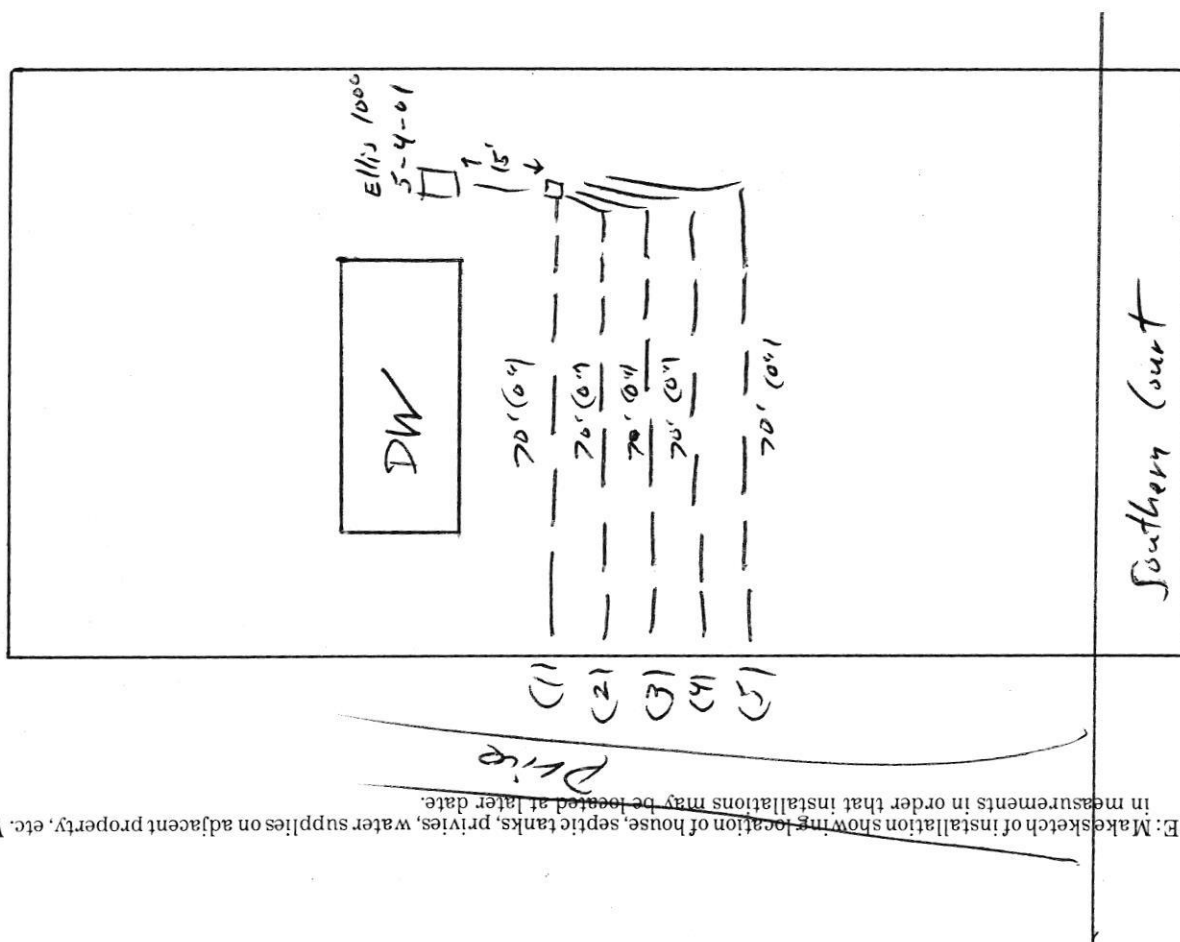

SP. 1425 Henry Wilson Rd

GRANVILLE-VANCE HEALTH DEPARTMENT—Sewage Disposal Record

Owner or Contractor Venturer & Henderson Date _____ S.R. No. _____

Location/Address Southern Court off Henry Wilson Rd

Subdivision/Mobile Home Park Name Pine Forest Lot Size _____

Permit No. # 3019 Lot No. 28

New System ☒ Repair _____

House _____ Mobile Home ☒ Business _____

No. Bedrooms 3 No. People _____ No. Toilets _____

Water Supply: Private ☒ Approved _____

Semi-Public _____ Unapproved _____

Public _____ None _____

Nitrification System:

Tank Size 1000 gal.

Distribution Box ☒ No. Lines 5

Nitrification Field 1371 Sq. Ft.

Lines:	1	2	3	4	5	6
Width	<u>3'</u>	<u>3'</u>	<u>3'</u>	<u>3'</u>	<u>3'</u>	
Length	<u>70'</u>	<u>70'</u>	<u>70'</u>	<u>70'</u>	<u>70'</u>	
Grade	<u>0'</u>	<u>0'</u>	<u>0'</u>	<u>0'</u>	<u>0'</u>	
Stone Depth	<u>12"</u>	<u>12"</u>	<u>12"</u>	<u>12"</u>	<u>12"</u>	

Layout to be followed by installer:

Improvements Permit By Eddie Yount Installer Tom Henderson

Certificate of Completion By Eddie Yount Date of Inspection 7-2-01

* Construction must comply with all other applicable state and local regulations, but the permit is not a guarantee that the system will not malfunction and the Granville-Vance Health District will not be held responsible for a malfunctioning system.