


Mike - Triangle Pump + Tank
 Large Layo 11:30 Thursday Oct. 10th
 11:30 2:00
 PERMIT NUMBER 3325
 File

GRANVILLE - VANCE DISTRICT HEALTH DEPARTMENT IMPROVEMENT AND OPERATION PERMITS

COUNTY: <i>Granville</i>	TAX NO. <i>192100</i>	TYPE OF ESTABLISHMENT			*THIS PERMIT SHALL BE ACCOMPANIED BY A LAYOUT SHOWN ON A PLAT, INCLUDING SYSTEM REQUIREMENTS. *THE IMPROVEMENTS PERMIT MUST BE ATTACHED TO A CONSTRUCTION AUTHORIZATION BEFORE OBTAINING BUILDING PERMIT OR OTHER CONSTRUCTION PERMITS AND BEFORE A WASTEWATER SYSTEM IS INSTALLED. *THIS IMPROVEMENT PERMIT IS SUBJECT TO REVOCATION IF THE INTENDED USE CHANGE FROM THOSE SHOWN ON THE IMPROVEMENT PERMIT. CHANGES SHALL REQUIRE HEALTH DEPARTMENT APPROVAL.
	SIR NO. <i>1705</i>	RESIDENCE ☒ BUSINESS ☐ OTHER ☐	NUMBER OF BEDROOMS: <i>3</i>	NUMBER OF OCCUPANTS:	
OWNER: <i>Alvin Moore</i>					
APPLICANT: <i>Advance Homes</i>		WATER SUPPLY			
APPLICANT'S ADDRESS: <i>10000 Highway 116 27596</i>		PUBLIC ☐	WELL ☐	OTHER ☐	
PROPERTY ADDRESS/LOCATION: <i>Maynard Circle</i> <i>old middle store rd</i>		TYPE OF WASTEWATER SYSTEM			
		DESCRIPTION	INITIAL INSTALLATION	REPAIR	
SUBDIVISION: <i>Grassfield</i>		DESIGN FLOW:	<i>360 gal/hr</i>		
LOT NUMBER: <i>62</i>		LTAR:	<i>.75</i>		
REFERENCE SKETCH (SEE PLAT FOR DETAILS) <i>See sketch on back. Dig trenches 18"-24" deep and on contour. Dig at least 5' from house to drain properly line & 100' from any well!</i>		ABSORPTION AREA:	<i>1050 sq. ft.</i>		
		TRENCH WIDTH:	<i>3'</i>		
		TRENCH SPACING:	<i>7' on center</i>		
		TOTAL TRENCH LENGTH:	<i>350 ft</i>		
		NUMBER OF TRENCHES:	<i>3-5</i>		
		GRAVEL DEPTH:	<i>12"</i>		
		TANK SIZE:	<i>1000 gal</i>		
		CONDITIONS:			
IMPROVEMENT PERMIT				DATE:	
FOR: <i>Alvin Moore / Advance Homes</i>				<i>2-18-02</i>	
ISSUED BY: <i>M.E. Spout, R.S.</i>					
OPERATION PERMIT				DATE:	
SYSTEM INSTALLED BY: <i>Triangle Pump + Tank</i>				<i>10-10-02</i>	
ISSUED BY: <i>Jimmy B. Clanton, R.S.</i>					

NOTE: Make sketch of installation showing location of house, septic tanks, privies, water supplies on adjacent property, etc. Write in measurements in order that installations may be located at later date.

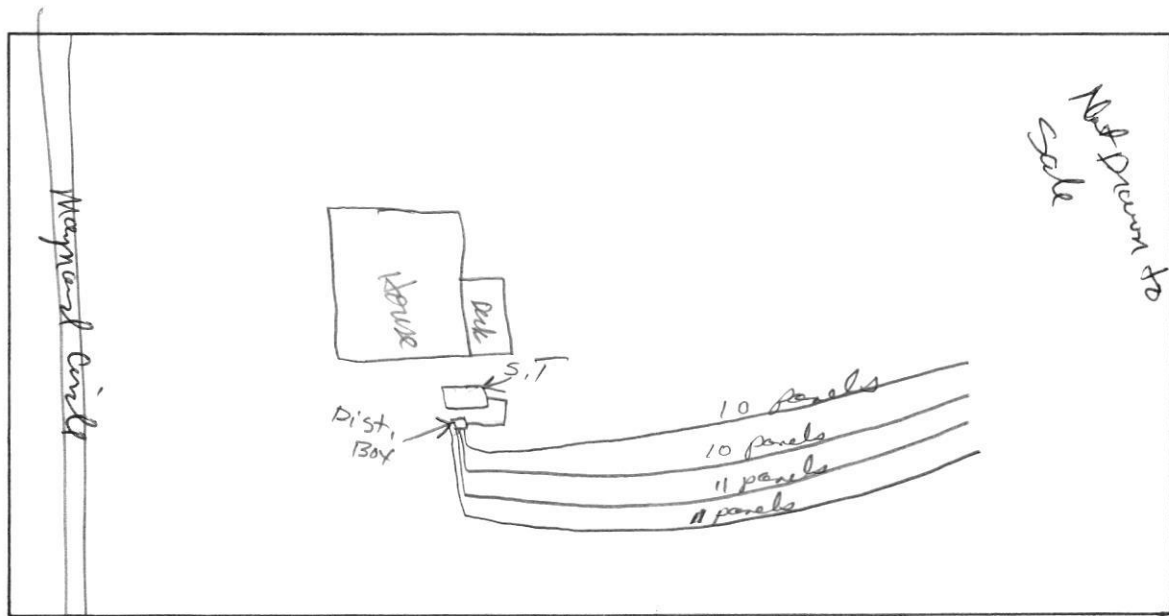

GRANVILLE-VANCE HEALTH DEPARTMENT—Sewage Disposal Record

Owner or Contractor Alvin Moore / advance Home Date 10-10-02 S.R. No. 1705

Location/Address _____

Subdivision/Mobile Home Park Name Brassfield Woods Lot Size 1.0189c

Permit No. # _____ Lot No. 62

New System ☒ Repair _____

House ☒ Mobile Home _____ Business _____

No. Bedrooms 3 No. People _____ No. Toilets _____

Water Supply: Private ☒ Approved _____

Semi-Public _____ Unapproved _____

Public _____ None _____

Nitrification System:

Tank Size 1000 gal.

Distribution Box ☒ No. Lines 4

Nitrification Field 787 Sq. Ft.

Lines: 1 2 3 4 5 6

Width 3 3 3 3 _____

Length 10 10 11 11 _____

Grade 0" 0" 0" 0" _____

Stone Depth paved infiltrator

Layout to be followed by installer:

Improvements Permit By M.E. YOUNT, R.S. Installer Triangle Pump & Tank

Certificate of Completion By Jimmy B. Clayton Date of Inspection 10-10-02

* Construction must comply with all other applicable state and local regulations, but the permit is not a guarantee that the system will not malfunction and the Granville-Vance Health District will not be held responsible for a malfunctioning system.