

Franklin County Health Department


Name: HYDE

Permit Number

7058

CONTRACTOR Dan Bentley TANK MANU D&B 2000 MANU DATE 6/5/13WELL INSTALLED YES _____ NO _____ SYSTEM CODE E21203SEPTIC SYSTEM LAYOUT
(SKETCH SYSTEM LAYOUT HERE)

→ landscape yard & fill in small ditches such that septic lines may cross. Install Ditch/Berm along property line (as on diagram) to catch surface water runoff and direct away from drain field. Do not park / ~~create~~ create driveway over drain field/septic tank.

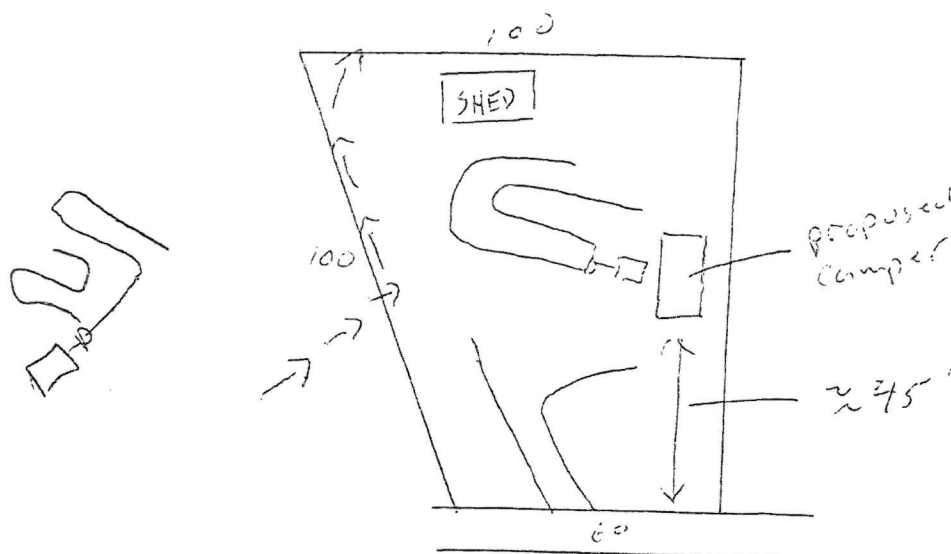

SEPTIC SYSTEM AS-BUILT

(IF DIFFERENT FROM INITIAL LAYOUT)

ON REVERSE

OPERATIONS PERMIT

DATE

9/9/13

EHS