


OWNER Breden Co. LRK 46320 255 Stoneyfield Dr ADDRESS Landhurst South
 OCCUPANT _____ SUBDIVISION _____
 HOUSE MOBILE HOME _____ BUSINESS _____ LOT AREA _____ LOT # 135
 SEPTIC TANK: (SIZE 2(1000) GALS.) PRIVY: (NUMBER _____)
 No. Bedrooms _____ No. Bathrooms _____ New _____ Date _____
 Garbage Disposal Unit Yes No _____ Repaired _____ Date _____
 Auto. Dishwasher Yes No _____ WATER SUPPLY:
 Auto. Wash. Machine Yes No _____ Individual _____ Public
 Nitrification Field 2(100' x 30') sq. ft. If well, type:
 Depth of stone in lines 12' Bored _____ Drilled _____ Dug _____
 FHA CASE # _____ VA CASE # _____ Distance from nearest
 FARMERS HOME ADM. CASE # _____ pollution _____ Ft.
 Contractor Bobby Holt REMARKS: Sand
 Address Cannon
 PERMIT # _____ DATE 6-30-80
 APPROVED: YES NO _____
 APPROVED BY: Monte S. Fry

DHS Form 1106 Rev. 2/75
Sanitation

SEWAGE DISPOSAL RECORD DEPARTMENT OF HUMAN RESOURCES
DIVISION OF HEALTH SERVICES

NOTE: Make sketch of installation showing location of house, septic tanks, privies, water supplies on adjacent property, etc. Write in measurements in order that installations may be located at later date.

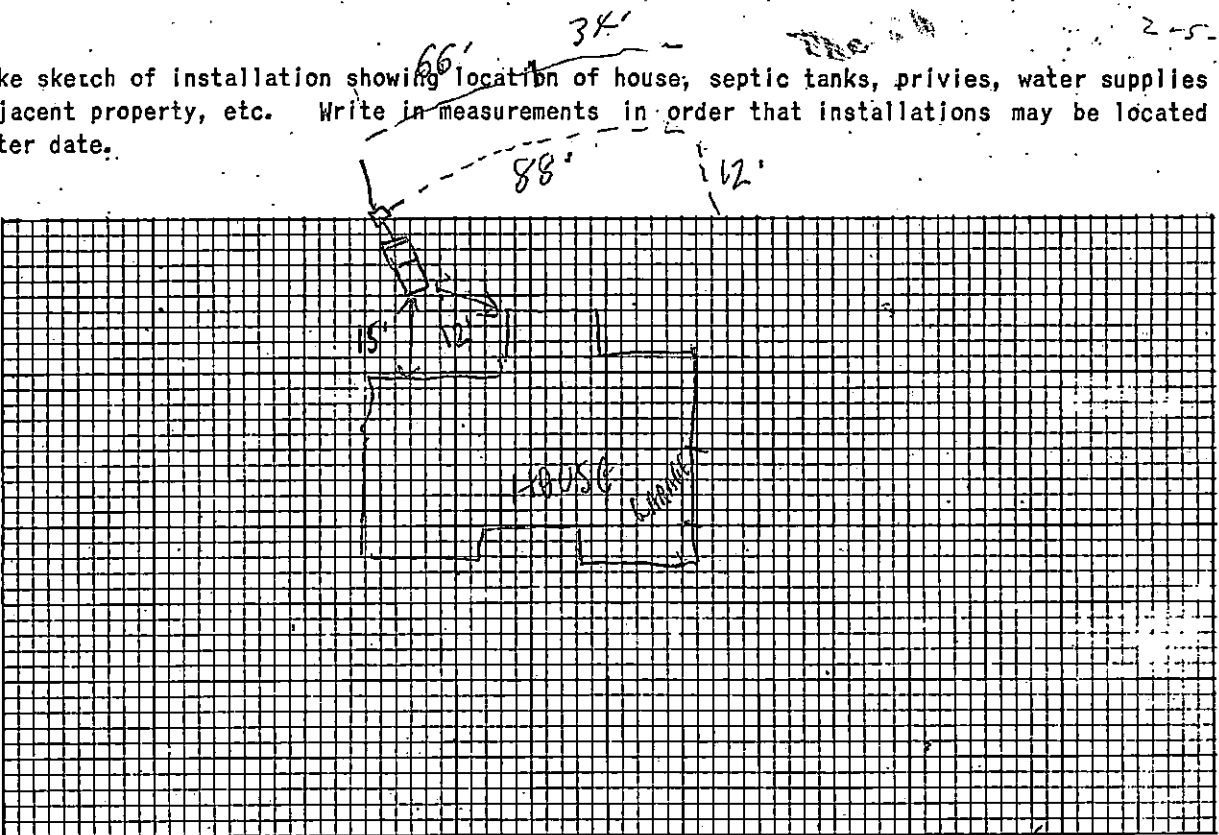

STREET