

Bottom of sewage line should be located _____ inches above or below original surface.


CRAVEN COUNTY HEALTH DEPARTMENT
DIVISION OF ENVIRONMENTAL HEALTH
P.O. Box 1390
New Bern, N.C. -- Phone 633-3488

THIS PERMIT IS VOID
THREE YEARS AFTER
DATE OF ISSUE
New Construction
Repair Work

IMPROVEMENT PERMIT

P
Neighbors Well No. 016982

Owner or Contractor: KENT BATMAN
Address: 5 Tyler Dr. HAYLOCK
Subdivision: _____ Lot: _____ Sec: _____
S.R. Number: 1703 Phone: 497-9395
Locations: Turn left on dirt road at end of 1703.
Type Structure: 1 house No. Bedrooms: 3
No. Persons: 2 Lot Size: 20,000
Soil Type: sandy Water Table: 3'
Additional Drainage: _____ Water Supply: Well
Septic Tank: 1000 gal. nitrification field: 800 sq. ft.
Grease Tank: - gal. nitrification field: - sq. ft.
Comments: Bed system - 40' x 20'. Lines will be 5 feet apart with the exterior line 1.5 feet from edge of the bed.

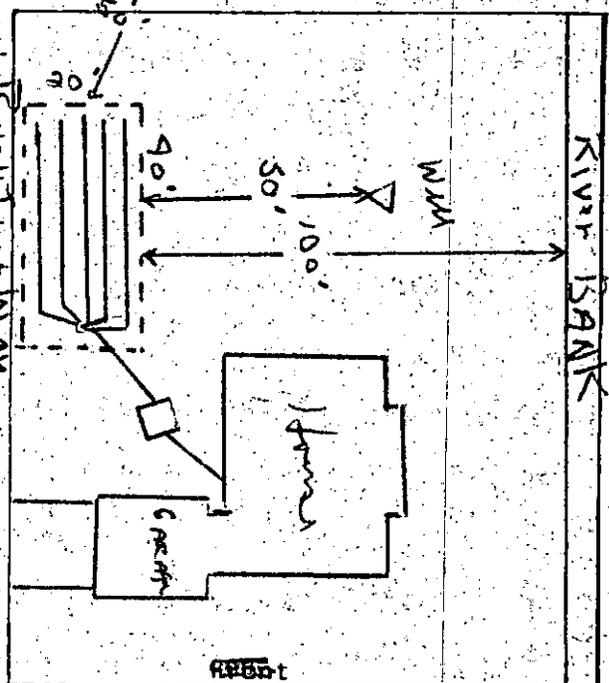

Date: 7-10-85 Sanitarian: [Signature]

Sketch: Indicates best location for above items. Contact Health Dept. prior to any changes.

(P) ON SITE SEWAGE SYSTEM PERMIT

This permit guarantees only materials used and method of installation and that it meets all local and state regulations.


Permission is hereby given to: James L. Cayton septic tank contractor to install and/or repair this sewage system.
Septic Tank: X Grease Trap: _____

Extra Inspection: _____ Total Fee: 15.00

Amount Received: _____

Remarks: _____

Approved: 5-23-85 Sanitarian: [Signature]

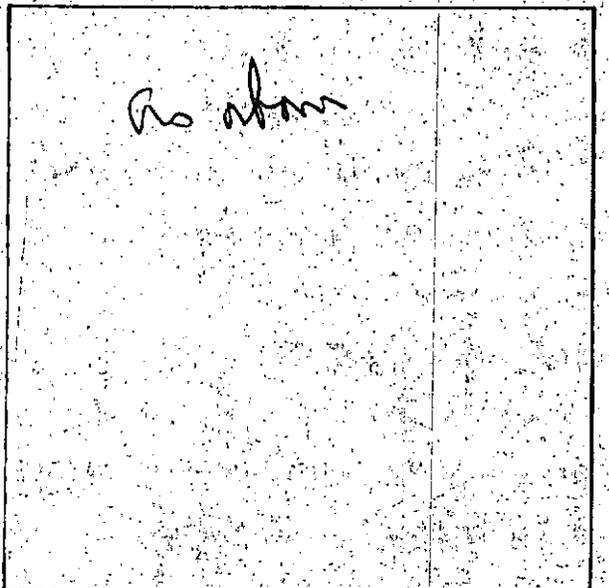

Front Sketch as installed

CERTIFICATE OF COMPLETION

Date of Approval: 5-23-85 Contractor: James Cayton By: [Signature] Sanitarian

HELPFUL HINTS FOR THE PROPER INSTALLATION OF
SEWAGE TREATMENT SYSTEMS

1. Sewage treatment systems should consist of a grease trap for laundry, kitchen sink and dish machine waste, and a septic tank for all bathroom waste. Mobile Homes are an exception when it is not feasible to separate the waste. One tank will be allowed for all waste.
2. The size of the septic tank and grease trap is dependent upon the amount of waste generated and is determined by the health department.
3. When more than one drain line is used per tank, a distribution box must be used. This is to assure equal distribution of the effluent into each drain line.
4. Drain lines should not exceed 75 feet in length and 3 feet in width. When more than 225 square feet is needed, two lines should be used. These lines should be equal length located no closer than 9 feet center to center. The bottom ditch should be evenly graded to prevent the pooling of effluent in segments of the drain field. When plastic tile is used, it should be secured to the grade board in such a manner that it will not move and change elevation. All drain lines will have a 6 inch grade board securely stacked on a grade not to exceed 1/4 inch fall per 10 feet of length. The rock shall be approved and 6 inches deep under the tile and 2 inches above, for a total of 12 inches.
5. Current regulations require that septic tanks, grease traps and drain fields shall be located at least 5 feet from building foundations; 10 feet from all property lines, or water lines under pressure; 25 feet from small ditches, cuts, slopes, or embankments; 50 feet from canals, large ditches, streams, marsh areas or lakes, and 100 feet from shellfish waters, any well and feeder streams emptying into shellfish waters.
6. Lines between septic tank or grease trap and distribution box shall be solid and sealed so as to be water tight. The distribution box shall be located so as to prevent its movement out of level. All lines from distribution box to drain fields should be solid water tight schedule 40 pipe for at least two feet from distribution box. Also, these lines shall be water tight until they reach a point 9 feet on center from other drain lines. Outlet pipes of the distribution box shall be tested with water for adequacy of level.
7. Discharge from water softener backwash, roof wash and other foreign sources of uncontaminated water should not be allowed into the systems. This may seriously change the chemical balance of the systems or cause other malfunctions. Also, effort should be made to prevent water standing on areas where drain lines are located. Excessive water can cause serious damage to the entire system.

All sewage disposal systems shall meet these requirements unless otherwise determined by the Craven County Health Department.

Contact your local health department for a guide for the use and care of your sewage treatment system.

CRAVEN COUNTY HEALTH DEPARTMENT
 DIVISION OF ENVIRONMENTAL HEALTH
 P.O. BOX 1390
 New Bern, NC - Phone 633-3488-3489

APPLICATION FOR THE IMPROVEMENT PERMIT

Date Received 17 May '85


Name KENT C. BATEMAN	Address 5 TYLER, HAVELOCK 28533	Phone 447-9345
Subdivision/Mobile Home Park ADAM CREEK AREA, TOWNSHIP #5	Lot No.	Section / Street

Location Description if not subdivided
**OFF SR. 1703 AT ADAMS CREEK AREA, GREAT NECK POINT,
 TOWNSHIP #5.**


Type structure

House
 Mobile Home
 Restaurant
 Condominium
 Townhouse
 Apartment/Duplex
 Business (Specify) _____
 Other (Specify) _____

No. of Bedrooms 3	No. of People Served 2	Type Water Supply <input type="checkbox"/> Community <input type="checkbox"/> Non Community <input checked="" type="checkbox"/> Individual
Plat Submitted <input checked="" type="checkbox"/> Yes <input type="checkbox"/> No <input type="checkbox"/> Not Required		Tri Party Agreement Submitted <input type="checkbox"/> Yes <input type="checkbox"/> No <input checked="" type="checkbox"/> Not Required

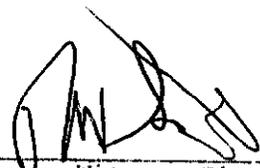

 Witness Signature

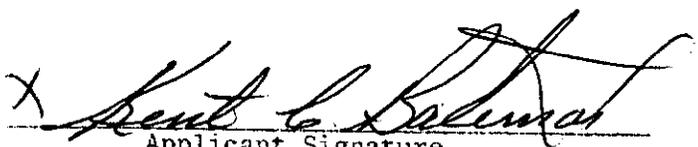X 

 Applicant Signature

Permit <input type="checkbox"/> Approved <input type="checkbox"/> Denied	Reason for Denial
---	-------------------