


I, Samuel T. Imman, Professional Land Surveyor, certify that the ratio of precision used in this survey meets the minimum standards of the State of North Carolina. Witness my hand and seal this 17th day of March, 2009.

Samuel T. Imman, P.L.S.

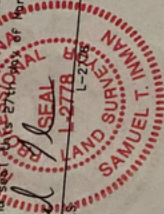


LOCATION MAP



NO SCALE

Bowberie Street 45' R/W


Kennington Square 45' R/W

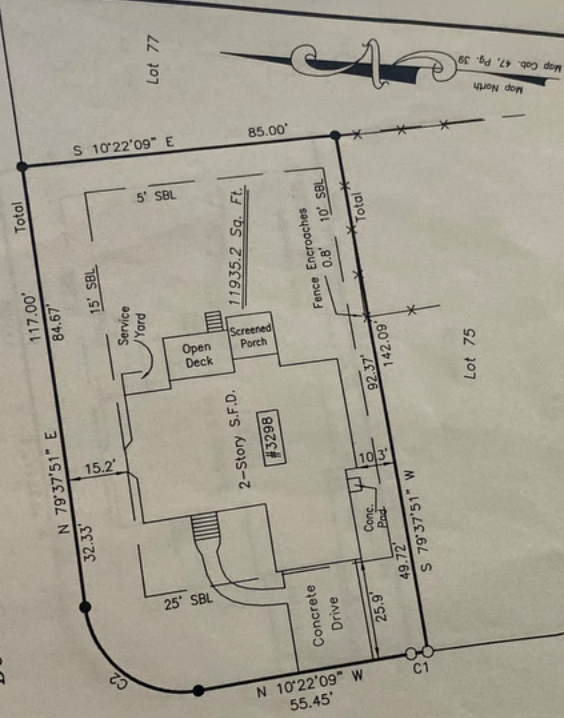

CURVE	CHORD BEARING	CHORD LENGTH	RADIUS
C1	N 09°05'38" W	4.55'	1190.82'
C2	N 34°37'00" E	35.35'	25.00'


As-Built Survey Of
Lot 76 - Phase 1 - Rutledge Subdivision

"Richard & Linda Callose"

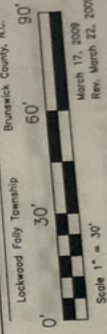

REFERENCE:
Deed Book 2345, Page 287
Map Cabinet 47, Page 39

- NOTES:
- Area By Coordinates
 - Fema Flood Map identifies parcel as being in Firm Zone X, Community Panel 370295 1097 J, 6/2/06.
 - Tax Parcel No.: 214C076

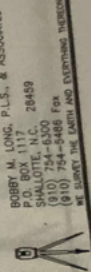

BOBBY M. LONG, P.L.S., & ASSOCIATES
P.O. BOX 111, C. 28459
SHALLOTTSVILLE, VA 22904
(810) 754-4466 Fax
(810) 754-4466
WE SURVEY THE EARTH AND DETERMINE BORDERS

Map North
Map Cab. 47, Pg. 39