

OWNER John Cook LRK 48137 156 Countryside Dr. ADDRESS Countryside Estate - Pritchett 5

OCCUPANT _____ SUBDIVISION _____

HOUSE MOBILE HOME BUSINESS _____ LOT AREA _____ LOT # 5

SEPTIC TANK: (SIZE 1000 GALS.) PRIVY: (NUMBER _____)

No. Bedrooms 3 No. Bathrooms 2 New _____ Date _____

Garbage Disposal Unit: Yes _____ No Repaired _____ Date _____

Auto. Dishwasher Yes No _____

Auto. Wash. Machine Yes No _____

Nitrification Field 2 (100' x 30') sq. ft. WATER SUPPLY: Individual Public _____

Depth of stone in lines 12" If well, type: Bored _____ Drilled _____ Dug _____

FHA CASE # _____ VA CASE # _____ Distance from nearest pollution _____ Ft.

FARMERS HOME ADM. CASE # _____

Contractor Jose Hernandez REMARKS: Sand

Address Pritchett

PERMIT # _____ DATE 12-22-81

APPROVED: YES NO _____


APPROVED BY: Mark S. Fry

DHS Form 1108 Rev. 2/75 Sanitation

SEWAGE DISPOSAL RECORD

DEPARTMENT OF HUMAN RESOURCES DIVISION OF HEALTH SERVICES

NOTE: Make sketch of installation showing location of house, septic tanks, privies, water supplies on adjacent property, etc. Write in measurements in order that installations may be located at later date.

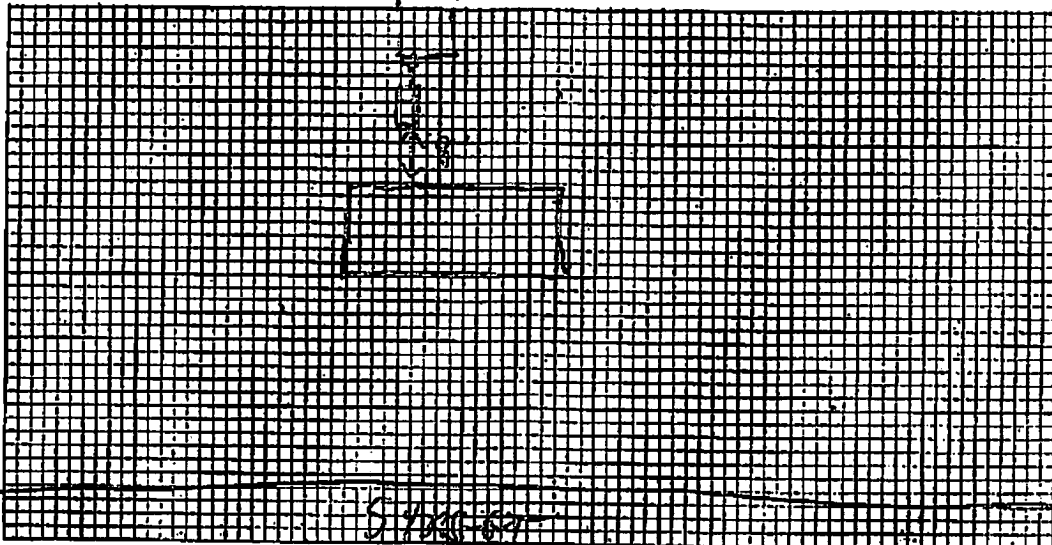

5/22/82