

5/22/2000

BRUNSWICK COUNTY HEALTH DEPARTMENT

*1994033929A

DATE REC: RUOCCO WILLIAM/MAUREEN P.I.N.: 85 217LA070 FILE NO: 2000030136

REC. FROM: 449 CEDARVIEW DR SE BOLIVIA NC TAX PARCEL 28422 (910) 842-

ADDRESS: RUOCCO WILLAM DENNIS ET MAUR RIVER RUN CITY ST ZIP PHONE

CURRENT PROPERTY OWNER SUBDIVISION LOT BLK SEC

PROPERTY LOCATED TOWN/CITY/AREA: 28422 3181 ISLAND DR SE DIRECTIONS TO PROPERTY: 3181 ISLAND DR SE 17 TO 211 TO SUNSET HARBOR RD TO RIV

AUTHORIZATION FOR WASTEWATER CONSTRUCTION PERMIT

NEW REVISION X RELOCATION UPGRADE REPAIR

Design Flow: 360 gpd. Septic tank size: 900 gal. Type: 2c

No. Bedrooms: 3 No. occupants/employees: 6 Max. Trench/Bed Bottom Depth: 18 inches

No. Lines: 2 Length each: 50' Bed dimensions: N/A

Fill Check: n/a Approved: n/a Date: Authorized Agent

PERMIT ISSUE DATE: 6/6/00 Permit expires 60 months from date of issue unless otherwise specified


- 30 days from date of issue
Other (date) Expires 6/6/05 1427

Authorized Agent Signature: JAD Date RS Registration: 1427

- NOTES:
1. Septic Tank shall have an approved effluent filter and access devices as applicable.
2. Maintain all setback distances for septic tank systems and wells.
3. All components of the septic systems shall be located 100 feet if possible but not less than 50 feet to all existing and future wells on this parcel and adjacent parcels.

NOTES: PERMIT IS SUBJECT TO REVOCATION IF SITE PLANS OR THE INTENDED USE CHANGES.

IMPROVEMENT PERMIT CONDITIONS MUST BE MET

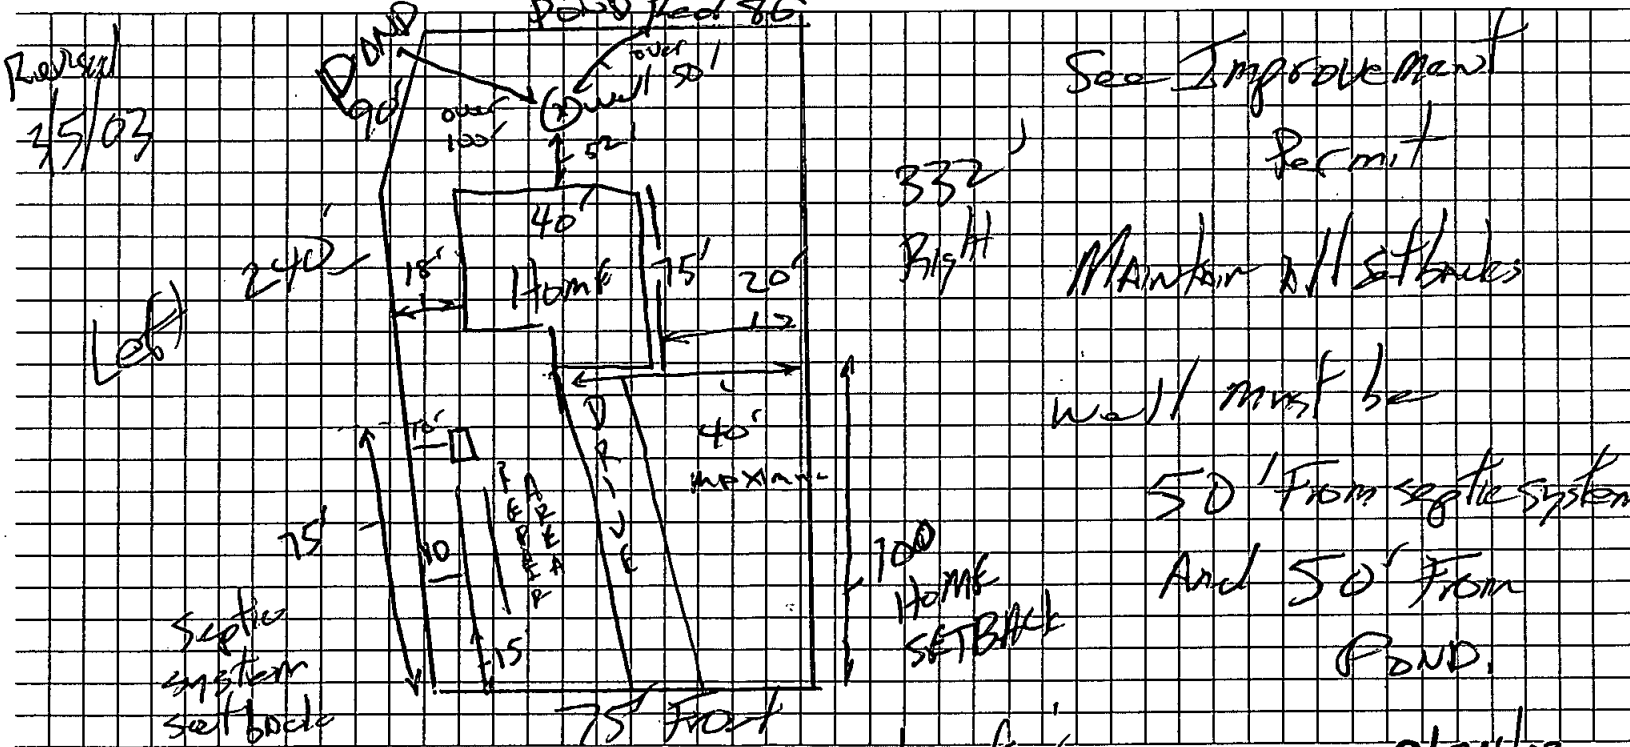

Wastewater System Installer: B&S Construction Date: 9/24/03

Comments: (tank info/barrier approved) QST-900 7/23/03

OPERATION PERMIT: JAD Date RS Date: 9/24/03

Actions of local health department representatives of the State engaged in the evaluation and determination of measures required to effect compliance with the applicable laws and rules shall in no way be taken as a warranty that sewage treatment and disposal systems approved and permitted will function in a satisfactory manner for any given period of time.



Brunswick County Health Department WELL PERMIT

Permit subject to revocation if site plan or intended use changes

File No: 94/33929A Revision

New Repair Renewal

W.M. D. Ruocco
Owner/Authorized Agent

OS 217LA070
Tax Parcel

449 Cedarview Dr. SE
Mailing Address

Bolivia NC 28422
City State Zip

River Run Plantation 70
Subdivision Lot

Block Section

Well Driller: T. Robinson

Certification: 2689

APPROVAL: AA Dumb RS
Signature of Authorized Agent

6/23/03
Date

Owner/Authorized Agent must contact the Health Department to request collection of a water sample after the well has been properly disinfected and electrical power is provided. Water testing is needed to validate well has been properly disinfected and safe for human consumption. To request water sample call toll free 1-888-428-4429.

Comments:

well over 100' to pond
wall over 25 to building; over 50' to coastal waters
Foundations over 50' to proposed
AS BUILT DIAGRAM 86' REAR Septic system

