

**Application for Service
Site Evaluation - Improvement Permit, Construction Authorization**

Applicant/Owner Information

Owner RRT DEVELOPMENT LLC

Phone (919)880-0058

DENNISPEACOCK@CA
ROLINACOMFORTAIR.
COM

Address 183 TEE DR
SELMA,NC 27576

Property Information

Parcel ID 10N07007P

Subdivision HONAKER FARMS 10

Zoning (COUNTY) AGRI. & RES. **Acreage** 0.7

Location

Project Information

LandUse # 214332 **Land Use Date** 12/23/2024

Facility Type NEW SEPTIC SYSTEM **Bedrooms** 4 **DDSF** 480
LHD

Requested Septic Type TRENCH **Water Type** JOCO PUBLIC UTILITIES **Drawing Type** SITE PLAN SUBMITTED

Environmentalist **Phone**

Type of Service Requested

*Fees are to be enclosed with completed application prior to obtaining a permit or service requested. Forward checks only if mail service is used.

Type of Service	Amount	Paid How	Date
LHD NEW SEPTIC	\$475.00	CHECK NUM 4335	2/21/2024
Total Paid:	\$475.00		

<u>DENNIS PEACOCK</u>	1/3/2025		1/3/2025
DENNIS PEACOCK Owner/Agent/Legal Representative		Issued By & Fees Paid To	

Owner Statement:

I certify that have read and examined this application and know the same to be true and correct. All provisions of laws and ordinances covering this type work will be complied with whether specified herein or not. The granting of a permit does not presume to give authority to violate or cancel the provisions of any other state or local law regulating construction. The owner /applicant will notify the Health Dept if this property contains designated wetlands of if the nature of the waterwater changes.

By affixing my signature to this application, I grant permission to perform the above requested services and certify that I fully acknowledge and understand that this application is merely an application for service and does not authorize installation or construction activity to begin until the completed application has been evaluated and approved by issuance of an appropriate permit signed by a duly authorized county official. Any site preparation or excavation or other installation of construction activity thta I might do prior to the approval and issuance of a valid and appropriate permit (or any other time without a lowfully issued permit) shall be at my own risk and any excavation, building, structure or other improvements not in compliance with all applicable county policies, or laws may be cause to be removed, revised or otherwise brought in to conformity at my own expense or cause the permit to be revoked.



JOHNSTON COUNTY ENVIRONMENTAL HEALTH DEPARTMENT

309 East Market Street, Smithfield, NC 27577
Phone: 919-989-5180 Fax: 919-989-5190
www.johnstonnc.com/envhealth

IMPROVEMENT PERMIT

Application #: 204628

Parcel #: 10N07007P

Name: RRT DEV.

Address: 183 TEE DYL City, State, Zip : Selma, NC 27576

Subdivision (if applicable): HONAKER FORMS Lot #: 10 Property Size: .70 Acre(s)

New Expansion Repair System Relocation Change of Use

Facility Type: Residential-SFD Number of Bedrooms: 4 Maximum # of Occupants: 8

Design Wastewater Strength: Domestic High Strength Industrial Process Wastewater

Proposed Design Daily Flow: 480 GPD Proposed LTAR (Initial) 0.3 Proposed LTAR-Repair Area: 0.3

Proposed Wastewater System (Initial): Accepted Classification Type: II b Pump Required: Yes No

Proposed Wastewater System (Repair): Accepted Classification Type: II b Pump Required: Yes No

Effluent Standard: DSE HSE NSF/ANSI 40 TS-I TS-II RCW

Saprolite System (Initial): Yes No Saprolite System (Repair): Yes No

Fill System (Initial): Yes No If yes, specify: New Existing (when adding more than 6 inches of fill to system area provide a fill plan)

Fill System (Repair): Yes No If yes, specify: New Existing (when adding more than 6 inches of fill to system area provide a fill plan)

Depth to LC (Initial)*: 46 inches Depth to LC (Repair)*: 46 inches * **Limiting Condition**

Max. Trench Depth (Initial)*: 18-20 inches Max. Trench Depth (Repair)*: 18-20 inches * **Measured on the downhill side of the trench**

Artificial Drainage Required: Yes No If yes, please specify details: _____

Type of Water Supply: Public Supply Private Well Community Well Shared Well Spring Other: _____

Drainfield location meets requirements of Rule .0508: Yes No Drainfield location meets requirements of Rule .0601: Yes No

Permit valid for: Five years [site plan submitted pursuant to GS 130A-334(13a)] No expiration [plat submitted pursuant to GS 130A-334(7a)]

Permit conditions:

fwf Authorized Agent's Printed Name: JP SMITH Issuance Date: 06/24/2024

Authorized Agent's Signature: Expiration Date: 06/25/2029

The issuance of this Improvement Permit (IP) in no way guarantees the issuance of other permits, approvals, or requirements by other local units of government, state or federal agencies (ie: building and/or zoning permits, mandatory sewer connections, etc.) Use of the site may be subject to all applicable development regulations/ordnances/rules/laws. This IP is subject to revocation and/or suspension if the site plan, plat, the intended use changes, or any unauthorized site disturbance, filling, soil removal or layout changes. The IP shall not be affected by a change of ownership of the site. This IP is subject to compliance with the provisions of 15A NCAC 18E and to the any conditions of this permit. The IP is valid for 5 years from the date of issuance unless otherwise indicated.

Signature of Owner/Legal Representative: DENNIS PEACOCK Date: Jan 03 2025


See attached site sketch

**IMPROVEMENT PERMIT
SITE SKETCH**

Application #: 204628
 Name: RRT DEV
 Address: 183 TEE DR City, State & Zip: Selma, NC 27576
 Subdivision (if applicable): HONAKER FARMS Lot #: 10 Property Size: .70 Acre(s)
 Authorized Agent's Printed Name: JP SMITH Date: 06/24/2024

System components represent approximate location of septic system and repair area. The contractor must flag the system prior to beginning the installation to ensure that the proper grade is maintained.

Scale: 1:40

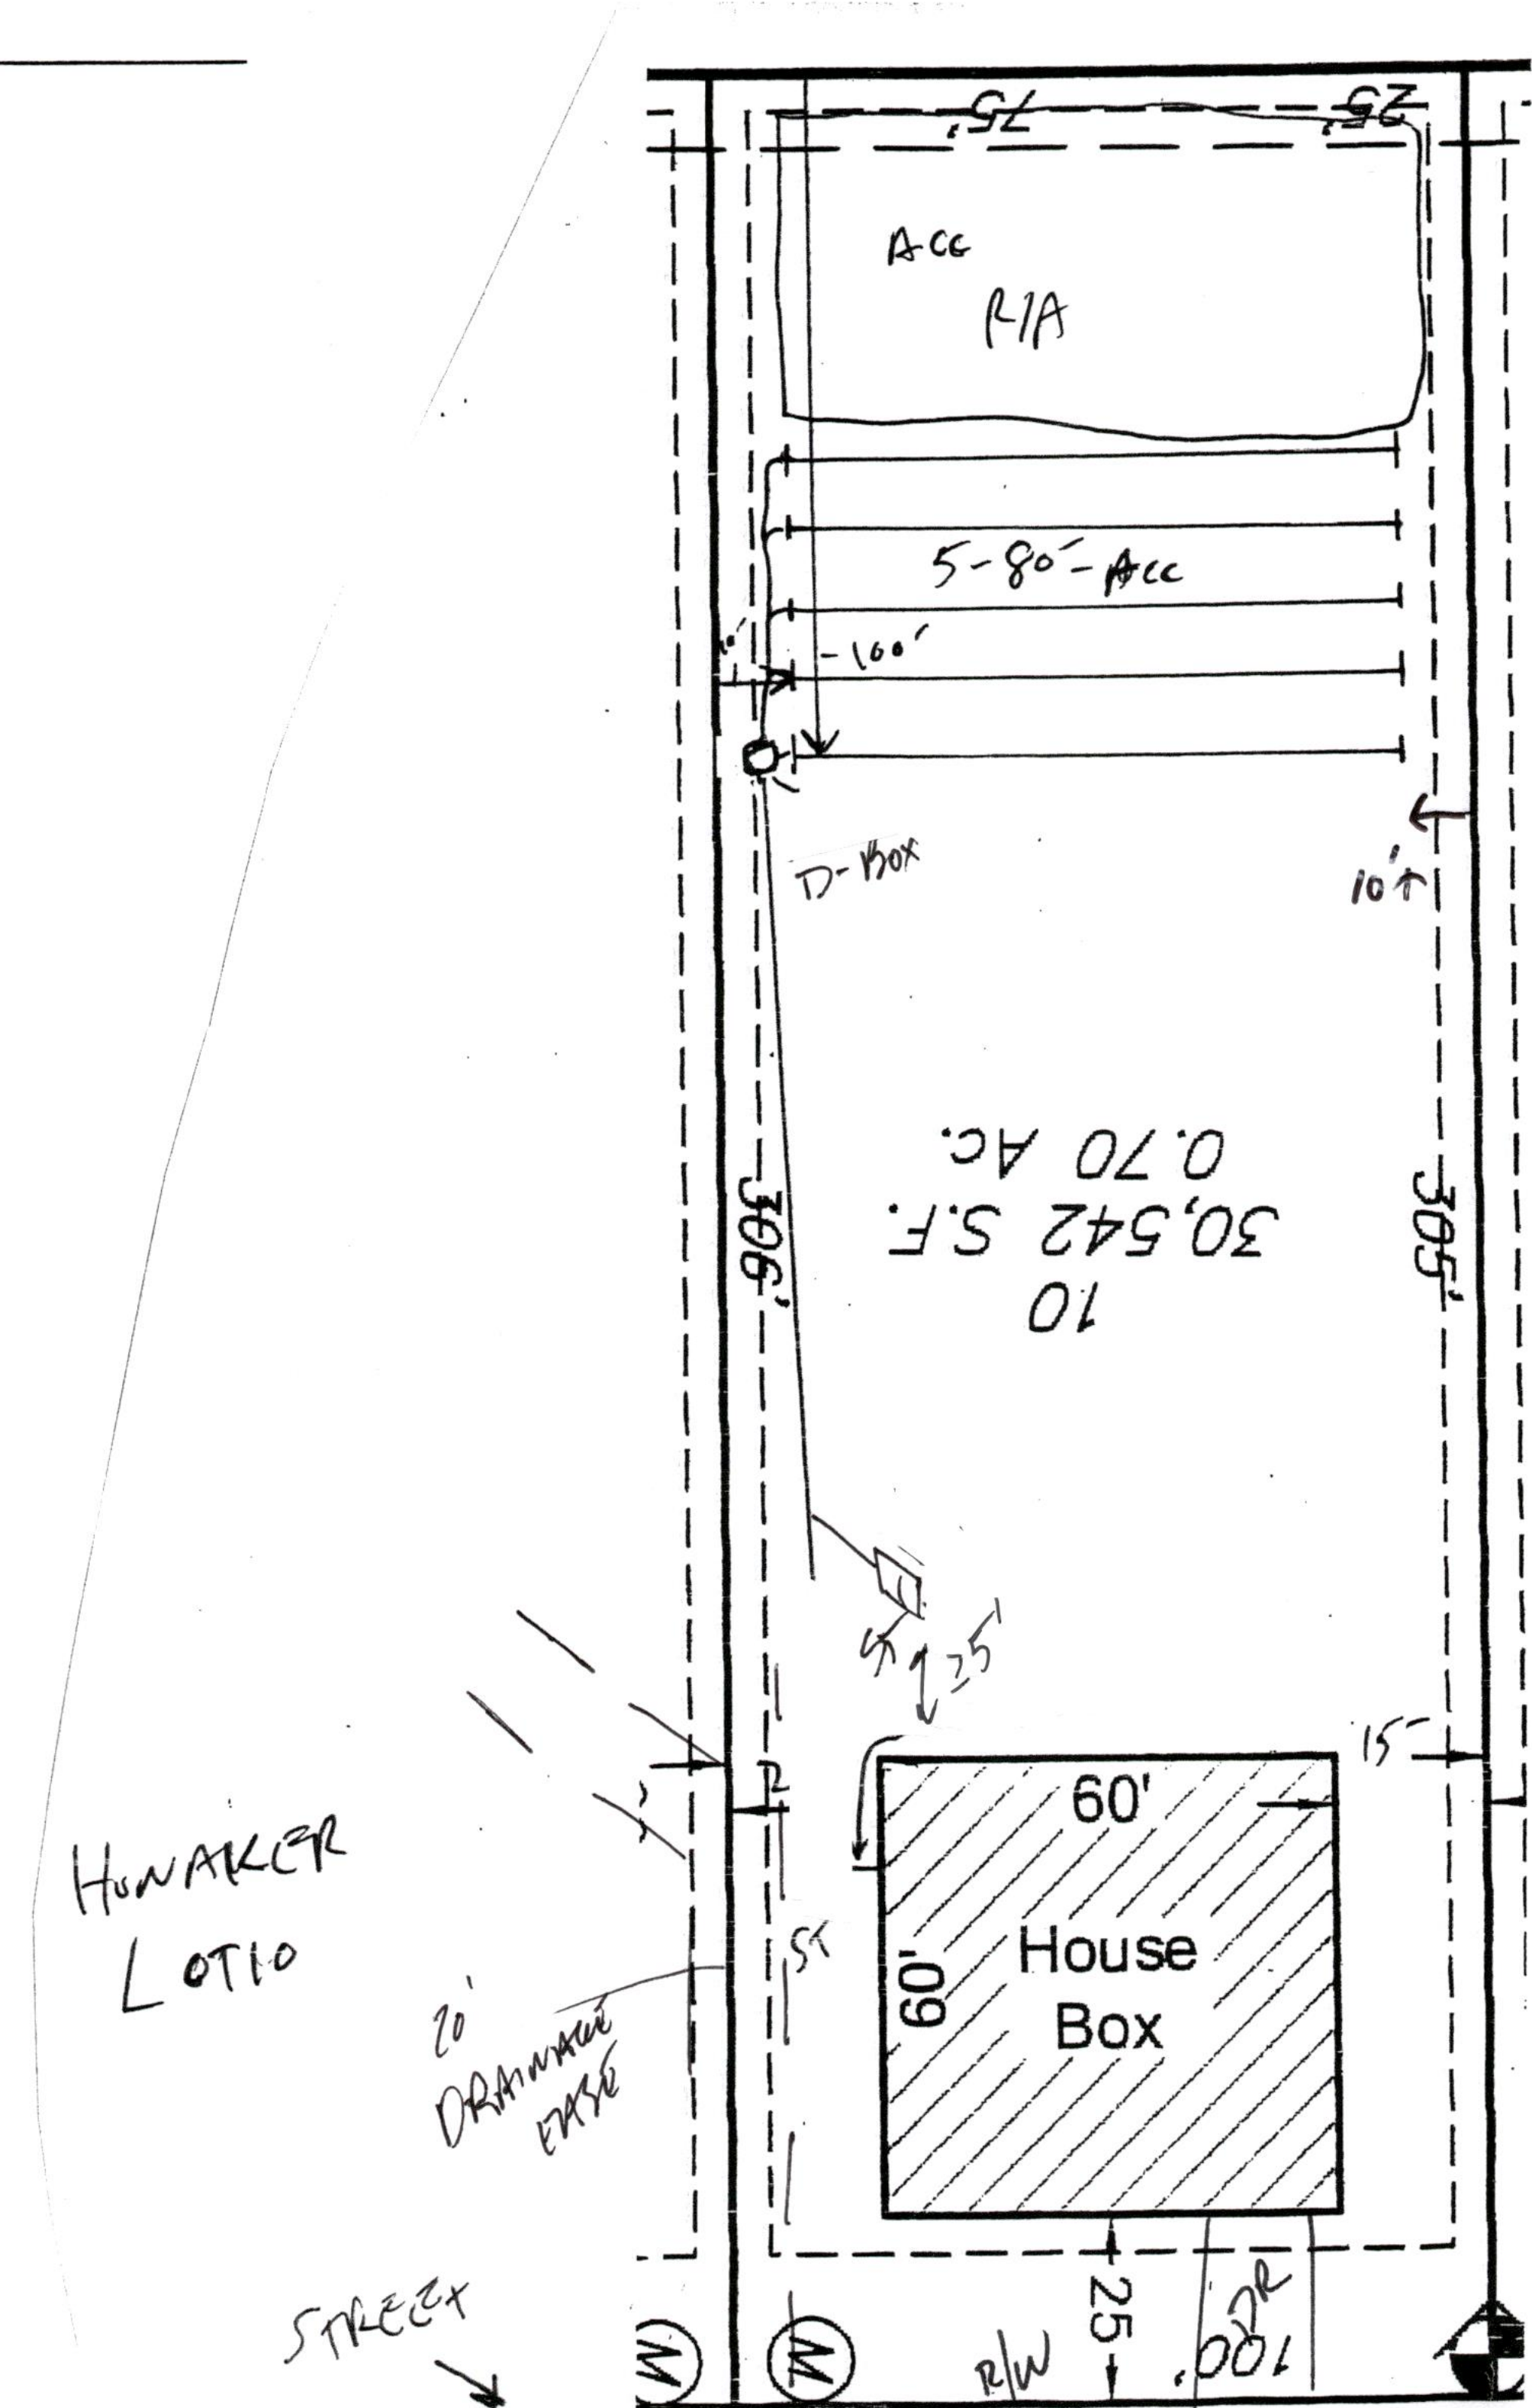



JOHNSTON COUNTY ENVIRONMENTAL HEALTH DEPARTMENT

309 East Market Street, Smithfield, NC 27577
Phone: 919-989-5180 Fax: 919-989-5190
www.johnstonnc.com/envhealth

CONSTRUCTION AUTHORIZATION

Application #: 204628 Parcel #: 10N07007 P

Name: RRT DEV

Address: 183 TEE DR City, State & Zip: Selma, NC 27576

Subdivision (if applicable): HONAKER FARMS Lot #: 10 Property Size: .70 Acre(s)

New Expansion Repair System Relocation Change of Use

Facility Type: Residential-SFD Number of bedrooms: 4 Maximum # of Occupants: 8

Basement: Yes No Basement Fixtures: Yes No Crawl Space: Yes No Slab Foundation: Yes No

Type of Wastewater System* Accepted (Initial) System Classification: II b

Accepted (Repair) System Classification: II b

Design Daily Flow: 480 GPD Wastewater Strength: Domestic High Strength Industrial Process Wastewater

Rule .0403(e) Engineering Design Utilizing Low-flow Fixtures and Low-flow Technologies (S.L. 2013-413 and 2014-120)? Yes No

(if yes, please provide engineering documentation)

Effluent Standard: DSE HSE NSF/ANSI 40 TS-I TS-II RCW

Type of Water Supply: Public Supply Private Well Community Well Shared Well Spring Other: _____

Installation Requirements/Conditions:

Septic Tank Size: 1000 gallons Grease Trap Size (if applicable): N/A gallons LTAR: 0.3 gpd/ft2

of Lines: 5 Length: 80 Trench Area: 1200 ft2

Trench Width: 36 inches Trench Spacing Minimum: 9 ft on center Additional Soil Cover: 0 inches

Slope Corrected Maximum Trench Depth#: 18-20 inches #Measures on the downhill side of the trench

Pump Tank Size (if applicable): -Select- N/A gallons Requires more than one pump? Yes No

Pump Requirements: N/A ft. TDH vs. N/A gpm Pressure Head: N/A Drawdown: N/A inches

Distribution Method: Serial D-Box or Parallel Pressure Manifold(s) LPP Other: _____

Artificial Drainage Required: Yes No If yes, please specify details: _____

Legal Agreements: (If the answer is "Yes" to any type of legal agreements, please attach a copy of the agreement.)

Multi-party Agreement Required [Rule .0204(g)]: Yes No Pre-Construction Conference Required: Yes No

Easement, Right-of-Way, or Encroachment Agreement Required [Rule .0204(d)]: Yes No

Management Entity Required: Yes No Minimum O&M Requirements: _____

Permit Conditions:

Authorized Agent's Printed Name: JP SMITH Issuance Date: 12-30-24

Authorized Agent's Signature: [Signature] Expiration Date: 12-30-29

The issuance of this Construction Authorization (CA) in no way guarantees the issuance of other permits, approvals, or requirements by other local units of government, state, federal (ie: building and or zoning permits, mandatory sewer connections, etc.) Use of the site may be subject to all applicable development regulations/ordinances/rule/law. The requirements of 15A NCAC 18E are incorporated by reference into this CA and shall be met. This CA is subject to compliance with the provisions of 15A NCAC 18E, or 15A NCAC 18A .1900, as applicable and to the conditions of this permit. This CA is subject to revocation and/or suspension, if the site plan, plat, intends use changes, or any unauthorized site disturbance, filling, soil removal, or layout changes. The CA is not affected by a change in ownership of the site and is valid for 5 years from the date of Improvement Permit issuance, unless otherwise indicated. Systems shall be installed in accordance with the attached site sketch.

Signature of Owner/Legal Representative: DENNIS PEACOCK Date: Jan 03 2025

See attached site sketch

**CONSTRUCTION AUTHORIZATION
SITE SKETCH**

Application #: 204628

Pre-Construction Conference Required: Yes No

Name: RRT DEV

Address: 183 TEE DR City, State, Zip: Selma, NC 27576


Subdivision (if applicable): HONAKER FARMS Lot #: 10 Property Size: .70 Acre(s)

Authorized Agent's Printed Name: JP SMITH Date: 05/02/2024

System components represent approximate location of septic system and repair area. The contractor must flag the system prior to beginning the installation to ensure that the proper grade is maintained.

Scale: 1:40

Slope Corrected Maximum Trench Depth: 18-20 inches ‡Measures on the downhill side of the trench

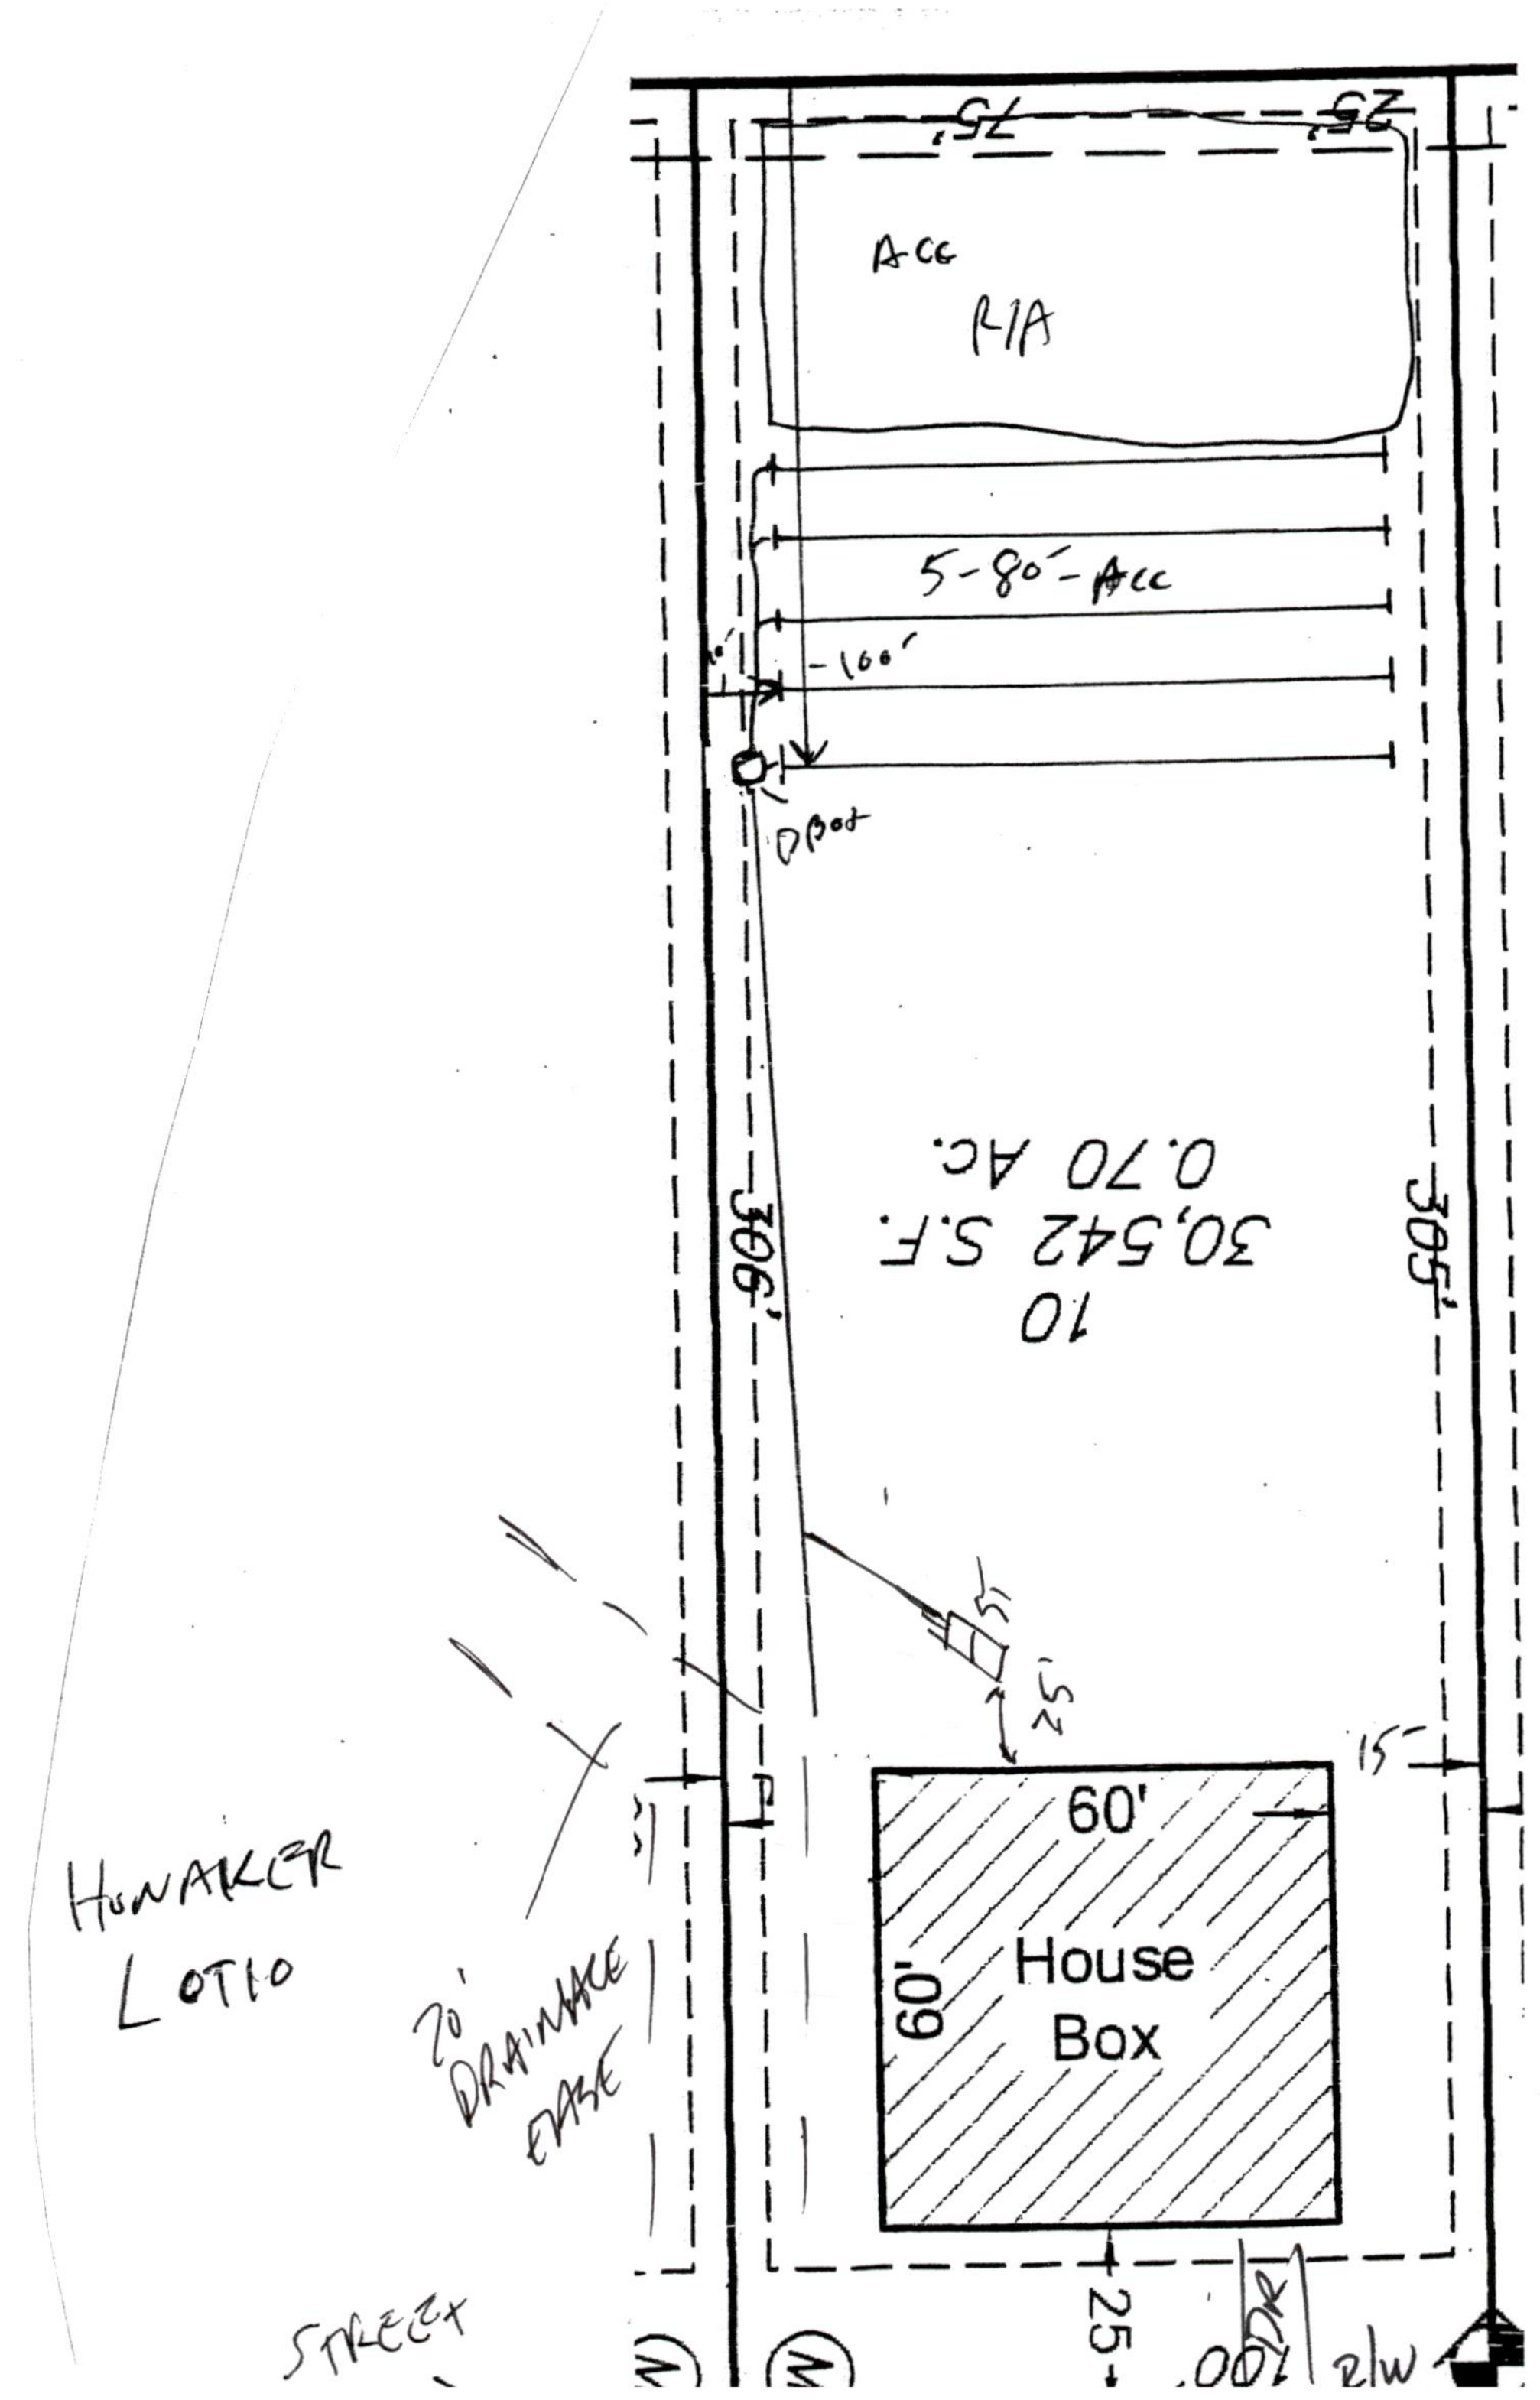

Document Details

Title	204628.pdf
File Name	204628.pdf
Document ID	730d165ea4644749849bcb7bdb97042f
Fingerprint	d9277f7476fb8d451f8989213aab029c
Status	Completed

Document History

Document Created	Document Created by Alisa Daughtry (alisa.daughtry@johnstonnc.com) Fingerprint: bd4d2b96269398b6ec2c7eec95d05b3f	Jan 03 2025 08:30AM America/New_York
Document Sent	Document Sent to DENNIS PEACOCK (DENNISPEACOCK@CAROLINACOMFORTAIR.COM)	Jan 03 2025 08:30AM America/New_York
Document Viewed	Document Viewed by DENNIS PEACOCK (DENNISPEACOCK@CAROLINACOMFORTAIR.COM) IP: 104.47.55.126	Jan 03 2025 09:08AM America/New_York
Document Viewed	Document Viewed by DENNIS PEACOCK (DENNISPEACOCK@CAROLINACOMFORTAIR.COM) IP: 96.10.23.202	Jan 03 2025 09:08AM America/New_York
Document Viewed	Document Viewed by DENNIS PEACOCK (DENNISPEACOCK@CAROLINACOMFORTAIR.COM) IP: 13.67.181.78	Jan 03 2025 09:08AM America/New_York
Document Signed	Document Signed by DENNIS PEACOCK (DENNISPEACOCK@CAROLINACOMFORTAIR.COM) IP: 96.10.23.202 DENNIS PEACOCK	Jan 03 2025 09:09AM America/New_York
Document Completed	This document has been completed. Fingerprint: d9277f7476fb8d451f8989213aab029c	Jan 03 2025 09:09AM America/New_York