



REVISÉ PER CO#2

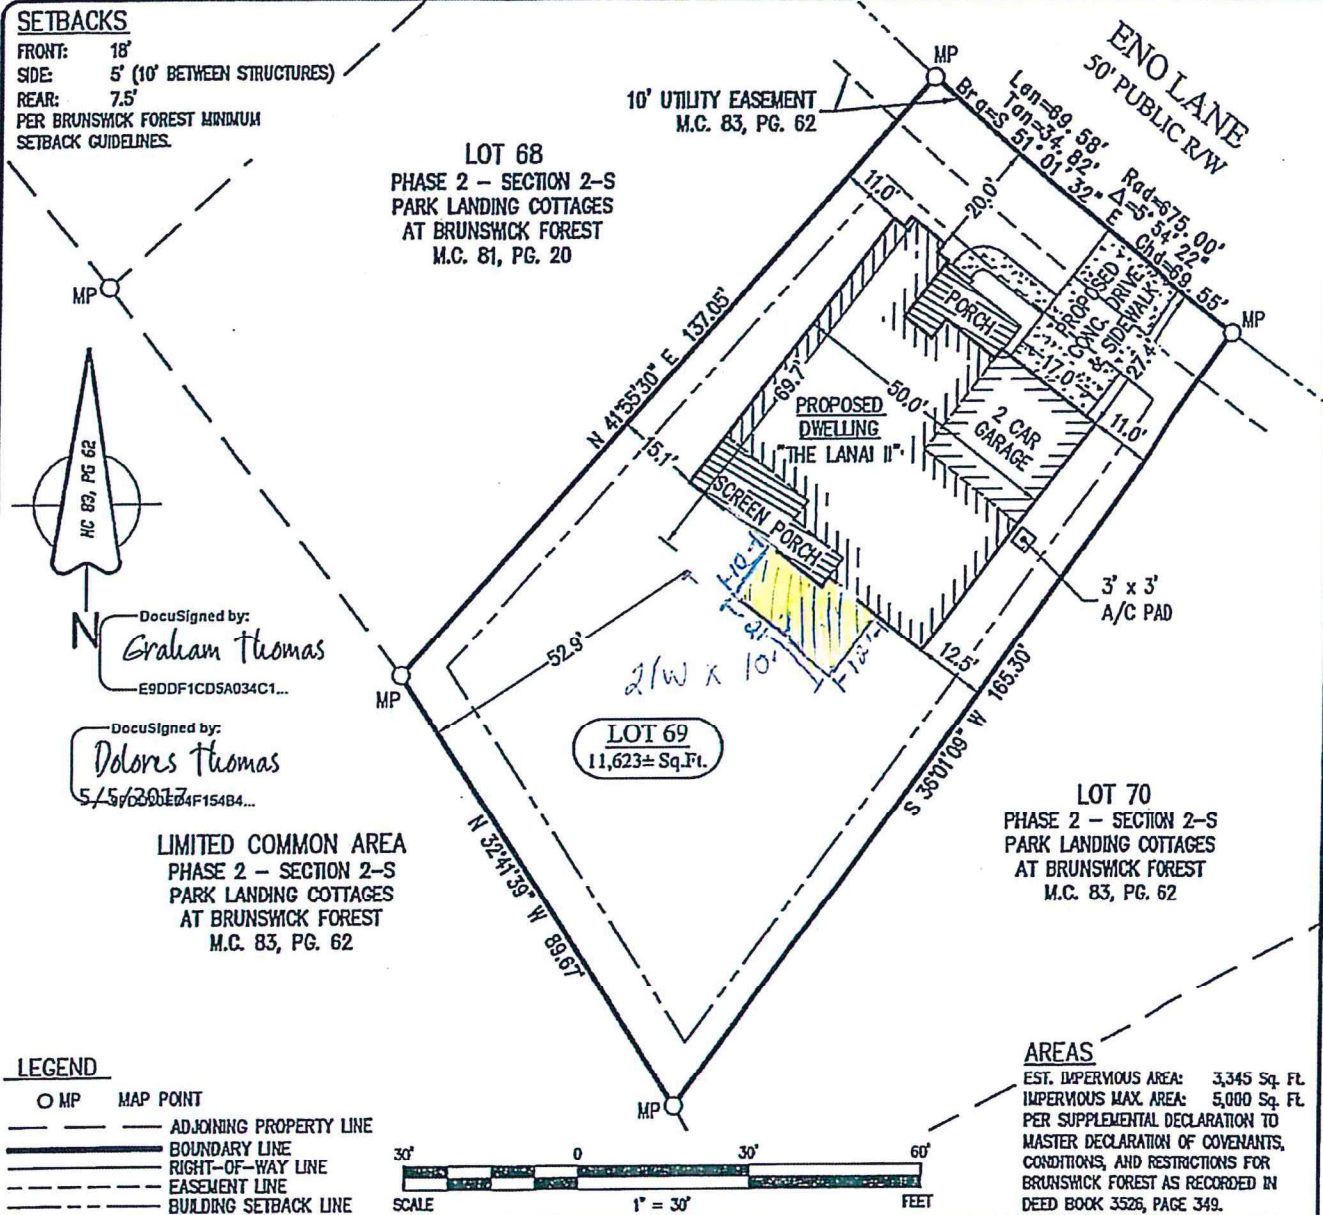

DocuSigned by:
Graham Thomas
E9DDF1CDS5A034C1...

DocuSigned by:
Dolores Thomas
5/5/2017
57000E74F154B4...

LIMITED COMMON AREA
PHASE 2 - SECTION 2-S
PARK LANDING COTTAGES
AT BRUNSWICK FOREST
M.C. 83, PG. 62

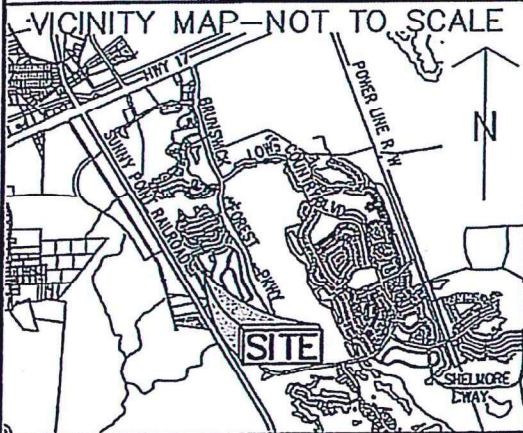

BILL CLARK HOMES OF WILMINGTON, LLC
LOT 69 - PHASE 2 - SECTION 2S - PARK LANDING COTTAGES AT BRUNSWICK FOREST-PID #058JD027 (3032 ENNO LANE)

NOTES:

- * PARCEL BOUNDARY REFERENCE: PARK LANDING COTTAGES AT BRUNSWICK FOREST, PH. 2, SEC. 2S PER M.C. 83, PG. 62.
- * THIS PROPERTY IS LOCATED IN FLOOD ZONE X ACCORDING TO DFIRM MAP #3720218600 J, DATED 6/2/06.
- * BUILDING PLAN PROVIDED BY BILL CLARK HOMES OF WILMINGTON.
- * THE PURPOSE OF THIS PLOT PLAN IS ONLY TO SHOW THE PROPOSED LOCATION OF THE FOUNDATION. THIS IS NOT AN AS-BUILT SURVEY OR BOUNDARY SURVEY.
- * THE IMPERVIOUS AREA SHOWN (IF ANY) IS AN ESTIMATE BASED ON THE FOUNDATION, DRIVEWAY AND WALKWAY LAYOUT AS SHOWN WITHIN THE BOUNDARIES OF THE LOT, AND EXCLUDES ANY AREAS WITHIN THE PUBLIC R/W.
- * PROPERTY ZONING: "PUD"

I HEREBY CERTIFY TO BILL CLARK HOMES OF WILMINGTON, LLC THAT THIS PLOT PLAN EXHIBIT IS A TRUE AND ACCURATE REPRESENTATION OF THE RECORDED PARCEL & PROPOSED HOUSE FOOTPRINT, AND THAT THE PLOT PLAN WAS PREPARED UNDER MY SUPERVISION.

PRELIMINARY
 NOT FOR RECORDING OR CONVEYANCE

MILES O. MCCALL III, PLS L-3316 DATE

PARK LANDING COTTAGES
AT BRUNSWICK FOREST - PHASE 2 - SECTION 2S
 MAP CABINET 83, PAGE 62
 Town Creek Township Brunswick County North Carolina

LOT 69
PROPOSED PLOT PLAN
THE LANAI II - GARAGE LEFT

ATLANTIC COAST SURVEY, PLLC
 LICENSE P-0022
 PO Box 12558, Wilmington, NC 28405
 (910) 443-0090 www.atlanticcoastsurvey.com