


AREA *.61 AC*
 26,724 Sq. Ft.
 (By Coord.)

FOSTER'S BAY



NOT FOR RECORDING

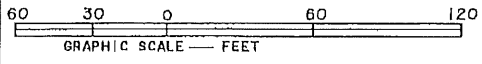

I, Pate D. Phillips, hereby certify that this map is correct and prepared according to the Standards of Practice for Land Surveying in North Carolina and that ~~there are no~~ ~~encroachments~~ ~~on said survey~~ the encroachments on said survey are as shown.

Pate D. Phillips PLS No. 2640
 Ratio of Precision - 1/10,000+

3-13-07

Swansboro Twp.
 Onslow County
 North Carolina
 Scale 1" = 60'
 March 8, 2007

REFERENCE:
 Deed Book 1570
 Page 607
 Onslow Co. Registry

BELL & PHILLIPS SURVEYING, PLLC
 604E Cedar Pt. Blvd.
 Cedar Point North Carolina
 (252)393-6101 Project No. 99-97

SURVEY FOR
JAMES E. MAIDES