

**Application for Service
Site Evaluation - Improvement Permit, Construction Authorization**

Applicant/Owner Information

Owner RRT DEVELOPMENT LLC

Phone (919)880-0058

DENNISPEACOCK@CA
ROLINACOMFORTAIR.
COM

Address 145 TEE DR
SELMA,NC 27576

Property Information

Parcel ID 10N07007R

Subdivision HONAKER FARMS 08

Zoning (COUNTY) AGRI. & RES. **Acreage** 0.7

Location

Project Information

LandUse # 214352 **Land Use Date** 12/23/2024

Facility Type NEW SEPTIC SYSTEM **Bedrooms** 3 **DDSF** 360
LHD

Requested Septic Type TRENCH **Water Type** JOCO PUBLIC UTILITIES **Drawing Type** SITE PLAN SUBMITTED

Environmentalist **Phone**

Type of Service Requested

*Fees are to be enclosed with completed application prior to obtaining a permit or service requested. Forward checks only if mail service is used.

Type of Service	Amount	Paid How	Date
LHD NEW SEPTIC	\$475.00	CHECK NUM 4335	2/21/2024
EFFLUENT PUMP FEE	\$50.00	VISA	1/3/2025
Total Paid:	\$525.00		

DENNIS PEACOCK

1/3/2025



1/3/2025

DENNIS PEACOCK Owner/Agent/Legal Representative

Issued By & Fees Paid To

Owner Statement:

I certify that have read and examined this application and know the same to be true and correct. All provisions of laws and ordinances covering this type work will be complied with whether specified herein or not. The granting of a permit does not presume to give authority to violate or cancel the provisions of any other state or local law regulating construction. The owner /applicant will notify the Health Dept if this property contains designated wetlands of if the nature of the waterwater changes.

By affixing my signature to this application, I grant permission to perform the above requested services and certify that I fully acknowledge and understand that this application is merely an application for service and does not authorize installation or construction activity to begin until the completed application has been evaluated and approved by issuance of an appropriate permit signed by a duly authorized county official. Any site preparation or excavation or other installation of construction activity thta I might do prior to the approval and issuance of a valid and appropriate permit (or any other time without a lowfully issued permit) shall be at my own risk and any excavation, building, structure or other improvements not in compliance with all applicable county policies, or laws may be cause to be removed, revised or otherwise brought in to conformity at my own expense or cause the permit to be revoked.



JOHNSTON COUNTY ENVIRONMENTAL HEALTH DEPARTMENT

309 East Market Street, Smithfield, NC 27577
Phone: 919-989-5180 Fax: 919-989-5190
www.johnstonnc.com/envhealth

IMPROVEMENT PERMIT

Application #: 204624

Parcel #: 10N01007R

Name: RRT Development

Address: 145 TEE DR City, State, Zip : Selma, NC 27576

Subdivision (if applicable): HONAKER FARMS Lot #: 8 Property Size: .70 Acre(s)

New Expansion Repair System Relocation Change of Use

Facility Type: Residential-SFD Number of Bedrooms: 3 Maximum # of Occupants: 6

Design Wastewater Strength: Domestic High Strength Industrial Process Wastewater

Proposed Design Daily Flow: 360 GPD Proposed LTAR (Initial) 0.3 Proposed LTAR-Repair Area: 0.3

Proposed Wastewater System (Initial): Accepted Classification Type: III b Pump Required: Yes No

Proposed Wastewater System (Repair): Accepted Classification Type: III b Pump Required: Yes No

Effluent Standard: DSE HSE NSF/ANSI 40 TS-I TS-II RCW

Saprolite System (Initial): Yes No Saprolite System (Repair): Yes No

Fill System (Initial): Yes No If yes, specify: New Existing (when adding more than 6 inches of fill to system area provide a fill plan)

Fill System (Repair): Yes No If yes, specify: New Existing (when adding more than 6 inches of fill to system area provide a fill plan)

Depth to LC (Initial)*: 44" inches Depth to LC (Repair)*: 44" inches * **Limiting Condition**

Max. Trench Depth (Initial)*: 18"-20" inches Max. Trench Depth (Repair)*: 18"-20" inches * **Measured on the downhill side of the trench**

Artificial Drainage Required: Yes No If yes, please specify details: _____

Type of Water Supply: Public Supply Private Well Community Well Shared Well Spring Other: _____

Drainfield location meets requirements of Rule .0508: Yes No Drainfield location meets requirements of Rule .0601: Yes No

Permit valid for: Five years [site plan submitted pursuant to GS 130A-334(13a)] No expiration [plat submitted pursuant to GS 130A-334(7a)]

Permit conditions:
-Do not cut, fill, or alter drain field or repair area -Comply with setbacks -Permit, Design, Layout and installation does not guarantee functionality -Contact Johnston County Environmental Health prior to or during installation with any questions -NOT TO SCALE

Authorized Agent's Printed Name: C. Eric Bass

Issuance Date: 12/5/2024

Authorized Agent's Signature: [Signature]

Expiration Date: 12/15/29

The issuance of this Improvement Permit (IP) in no way guarantees the issuance of other permits, approvals, or requirements by other local units of government, state or federal agencies (ie: building and/or zoning permits, mandatory sewer connections, etc.) Use of the site may be subject to all applicable development regulations/ordnances/rules/laws. This IP is subject to revocation and/or suspension if the site plan, plat, the intended use changes, or any unauthorized site disturbance, filling, soil removal or layout changes. The IP shall not be affected by a change of ownership of the site. This IP is subject to compliance with the provisions of 15A NCAC 18E and to the any conditions of this permit. The IP is valid for 5 years from the date of issuance unless otherwise indicated.

Signature of Owner/Legal Representative: DENNIS PEACOCK Date: Jan 03 2025

IMPROVEMENT PERMIT
SITE SKETCH

Application #: 204624

Name: RRT Development


Address: 145 TEE DR City, State & Zip: Selma NC

Subdivision (if applicable): HONAKER FARMS Lot #: 8 Property Size: _____ Acre(s)

Authorized Agent's Printed Name: C. Eric Bass Date: 12/5/2024

System components represent approximate location of septic system and repair area. The contractor must flag the system prior to beginning the installation to ensure that the proper grade is maintained.

Scale: NOT TO SCALE

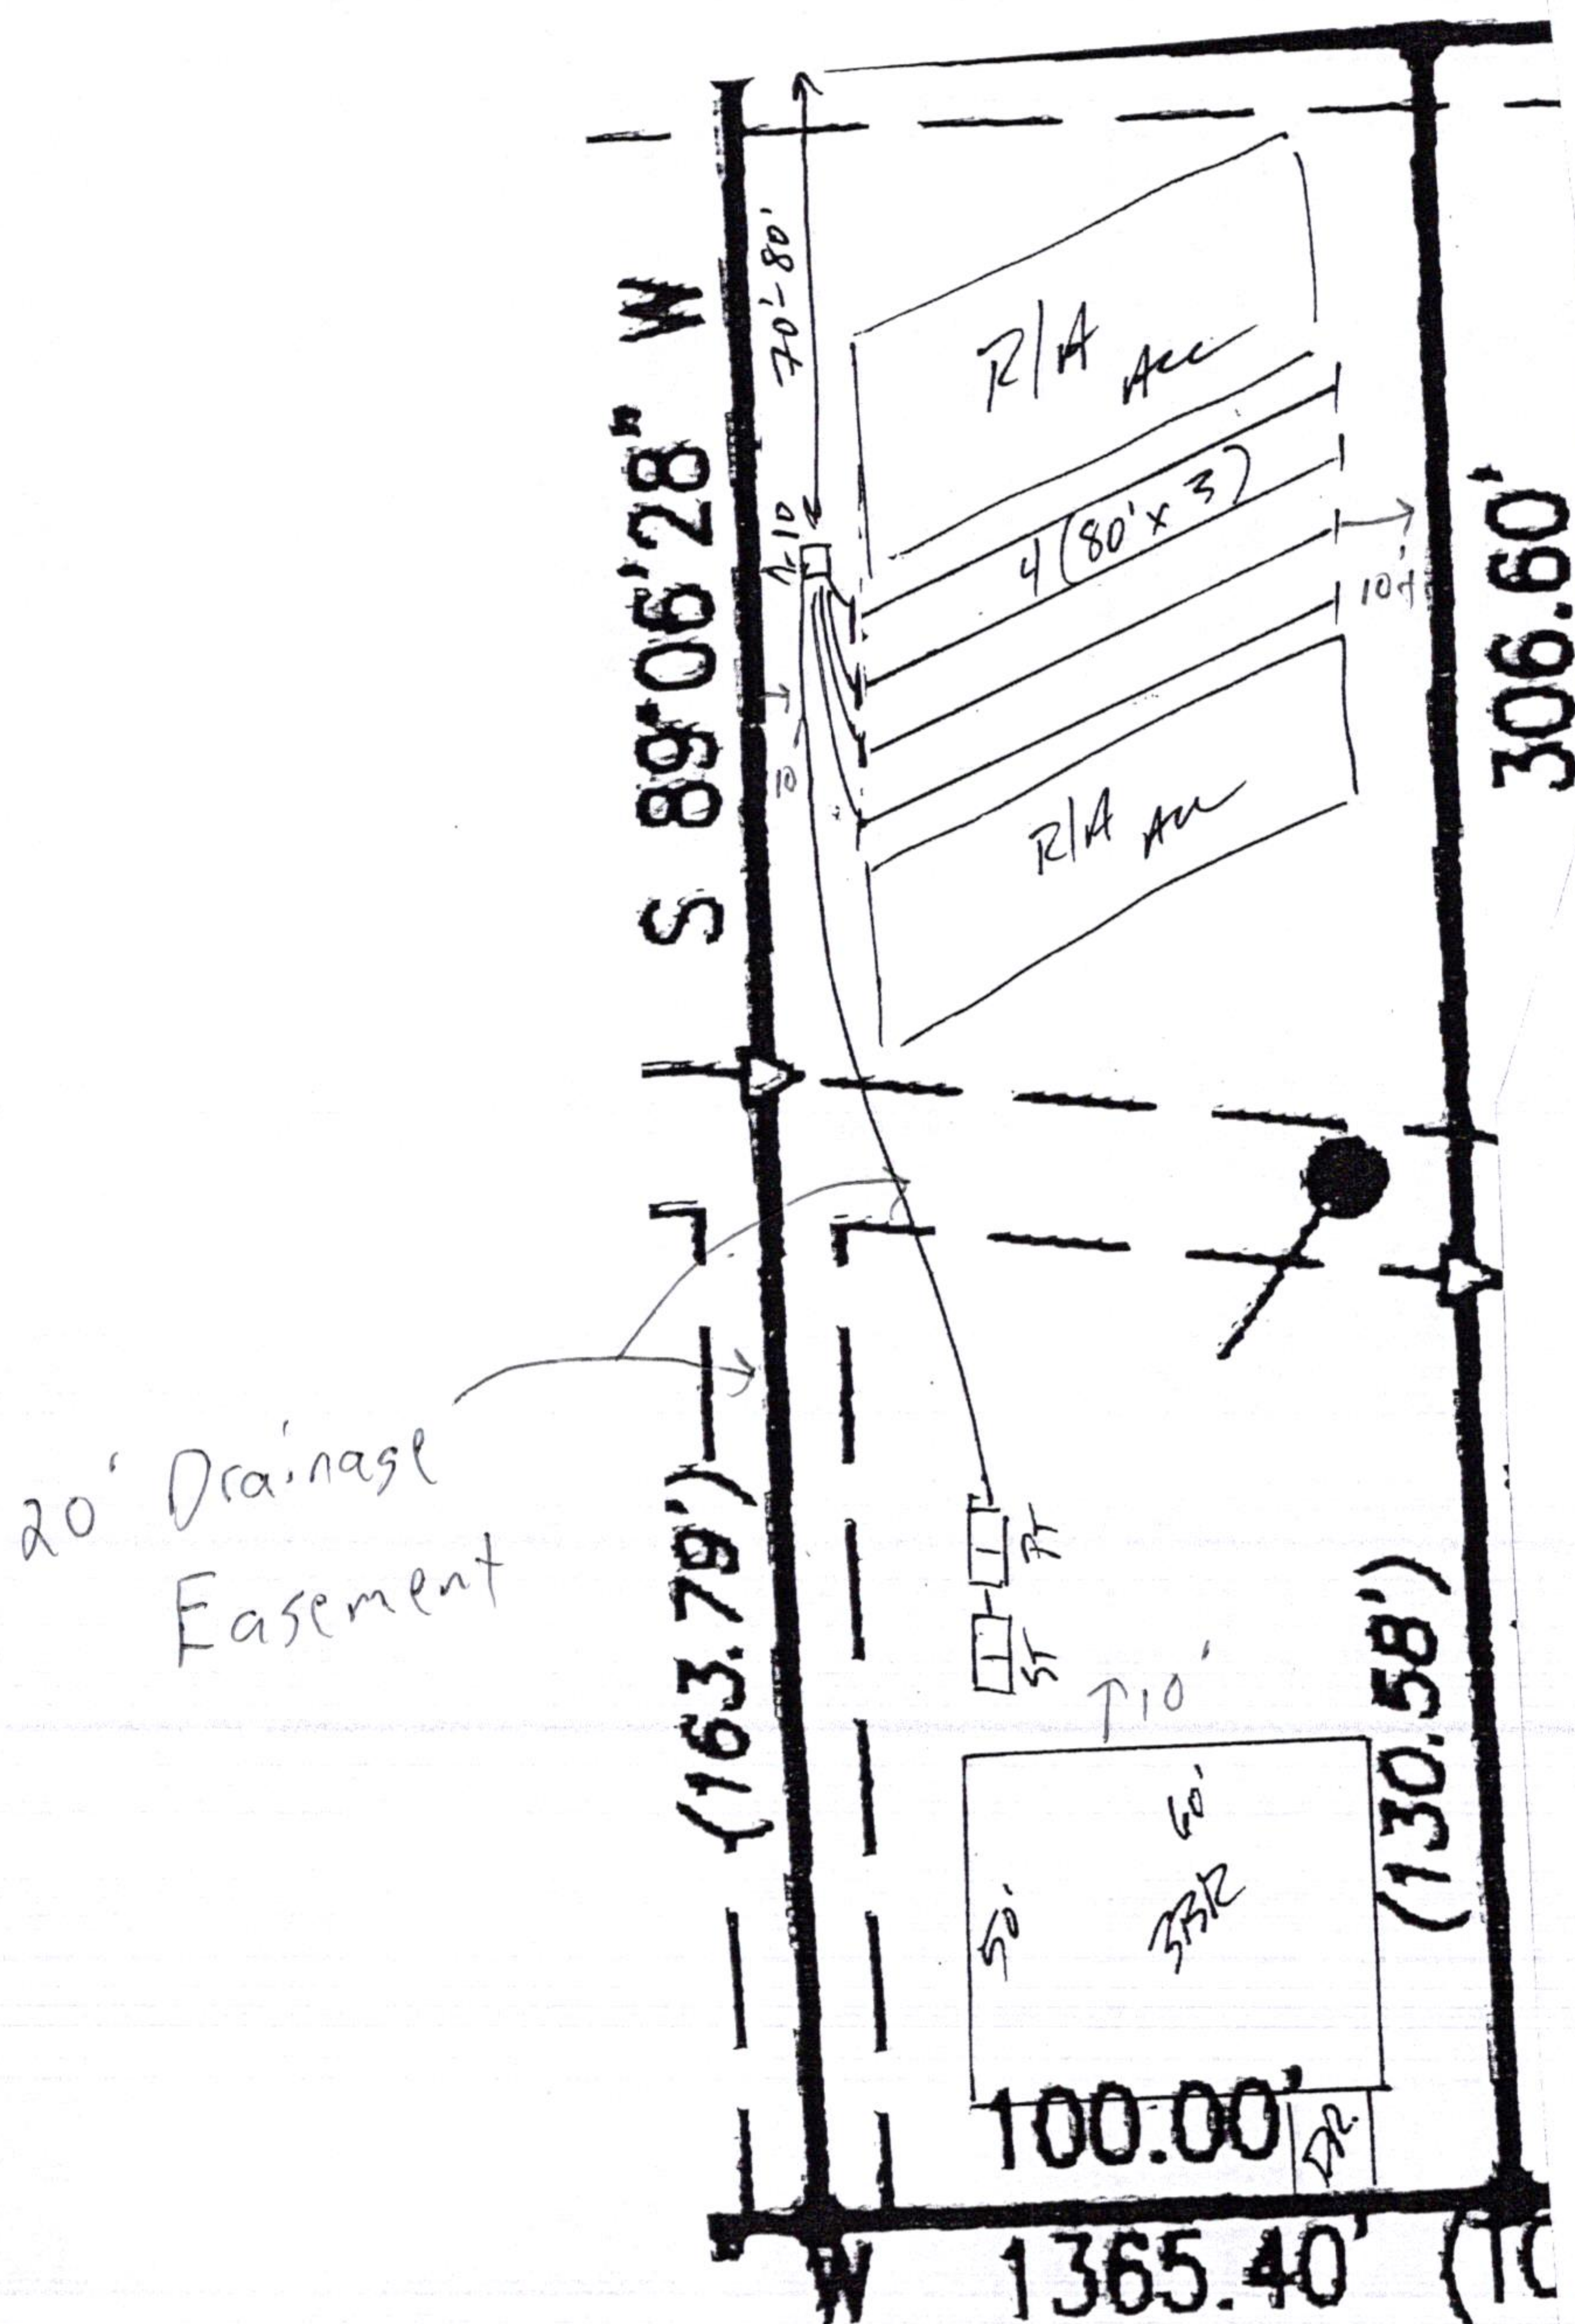



JOHNSTON COUNTY ENVIRONMENTAL HEALTH DEPARTMENT

309 East Market Street, Smithfield, NC 27577
Phone: 919-989-5180 Fax: 919-989-5190
www.johnstonnc.com/envhealth

CONSTRUCTION AUTHORIZATION

Application #: 204624 Parcel #: 10N07007R

Name: RRT Development

Address: 145 TEE DR. City, State & Zip: Selma, NC 27576

Subdivision (if applicable): NONAICER FARMS Lot #: 8 Property Size: .70 Acre(s)

New Expansion Repair System Relocation Change of Use

Facility Type: Residential-SFD Number of bedrooms: 3 Maximum # of Occupants: 6

Basement: Yes No Basement Fixtures: Yes No Crawl Space: Yes No Slab Foundation: Yes No

Type of Wastewater System* Accepted (Initial) System Classification: III b

Accepted (Repair) System Classification: III b

Design Daily Flow: 360 GPD Wastewater Strength: Domestic High Strength Industrial Process Wastewater

Rule .0403(e) Engineering Design Utilizing Low-flow Fixtures and Low-flow Technologies (S.L. 2013-413 and 2014-120)? Yes No

(if yes, please provide engineering documentation)

Effluent Standard: DSE HSE NSF/ANSI 40 TS-I TS-II RCW

Type of Water Supply: Public Supply Private Well Community Well Shared Well Spring Other: _____

Installation Requirements/Conditions:

Septic Tank Size: 1000 gallons Grease Trap Size (if applicable): N/A gallons LTAR: 0.3 gpd/ft²

of Lines: 4 Length: 80 Trench Area: 960 ft²

Trench Width: 36 inches Trench Spacing Minimum: 9 ft on center Additional Soil Cover: N/A inches

Slope Corrected Maximum Trench Depth: 18"-20" inches #Measures on the downhill side of the trench

Pump Tank Size (if applicable): 1000 gallons Requires more than one pump? Yes No

Pump Requirements: 10' ft. TDH vs. 28 gpm Pressure Head: N/A Drawdown: 7 inches

Distribution Method: Serial D-Box or Parallel Pressure Manifold(s) LPP Other: _____

Artificial Drainage Required: Yes No If yes, please specify details: _____

Legal Agreements: (If the answer is "Yes" to any type of legal agreements, please attach a copy of the agreement.)

Multi-party Agreement Required [Rule .0204(g)]: Yes No Pre-Construction Conference Required: Yes No

Easement, Right-of-Way, or Encroachment Agreement Required [Rule .0204(d)]: Yes No

Management Entity Required: Yes No Minimum O&M Requirements: _____

Permit Conditions:

-Contact Johnston County Environmental Health prior to or during installation with any questions -NOT TO SCALE -Do not cut, fill, or alter drain field or repair area -Comply with setbacks -Permit, Design, Layout and installation does not guarantee functionality

Authorized Agent's Printed Name: C. Eric Bass Issuance Date: 1/2/25

Authorized Agent's Signature: [Signature] Expiration Date: 1/2/30

The issuance of this Construction Authorization (CA) in no way guarantees the issuance of other permits, approvals, or requirements by other local units of government, state, federal (ie: building and or zoning permits, mandatory sewer connections, etc.) Use of the site may be subject to all applicable development regulations/ordinances/rule/law. The requirements of 15A NCAC 18E are incorporated by reference into this CA and shall be met. This CA is subject to compliance with the provisions of 15A NCAC 18E, or 15A NCAC 18A .1900, as applicable and to the conditions of this permit. This CA is subject to revocation and/or suspension, if the site plan, plat, intends use changes, or any unauthorized site disturbance, filling, soil removal, or layout changes. The CA is not affected by a change in ownership of the site and is valid for 5 years from the date of Improvement Permit issuance, unless otherwise indicated. Systems shall be installed in accordance with the attached site sketch.

Signature of Owner/Legal Representative: DENNIS PEACOCK Date: Jan 03 2025

See attached site sketch

**CONSTRUCTION AUTHORIZATION
SITE SKETCH**

Application #: 204624

Pre-Construction Conference Required: Yes No

Name: RRT Development

Address: 145 TEE DR. City, State, Zip: Selma NC

Subdivision (if applicable): HONAKER FARMS Lot #: 8 Property Size: .70 Acre(s)


Authorized Agent's Printed Name: C. Eric Bass Date: 10/28/24

System components represent approximate location of septic system and repair area. The contractor must flag the system prior to beginning the installation to ensure that the proper grade is maintained.

Scale: NOT TO SCALE Slope Corrected Maximum Trench Depth: 18"-20" inches ‡Measures on the downhill side of the trench

*‡Install supply line 3' deep in
20' Drainage Easement.*

- NOT TO SCALE
- Do not cut, fill, or alter drain field or repair area
- Comply with setbacks
- Permit, Design, Layout and installation does not guarantee functionality

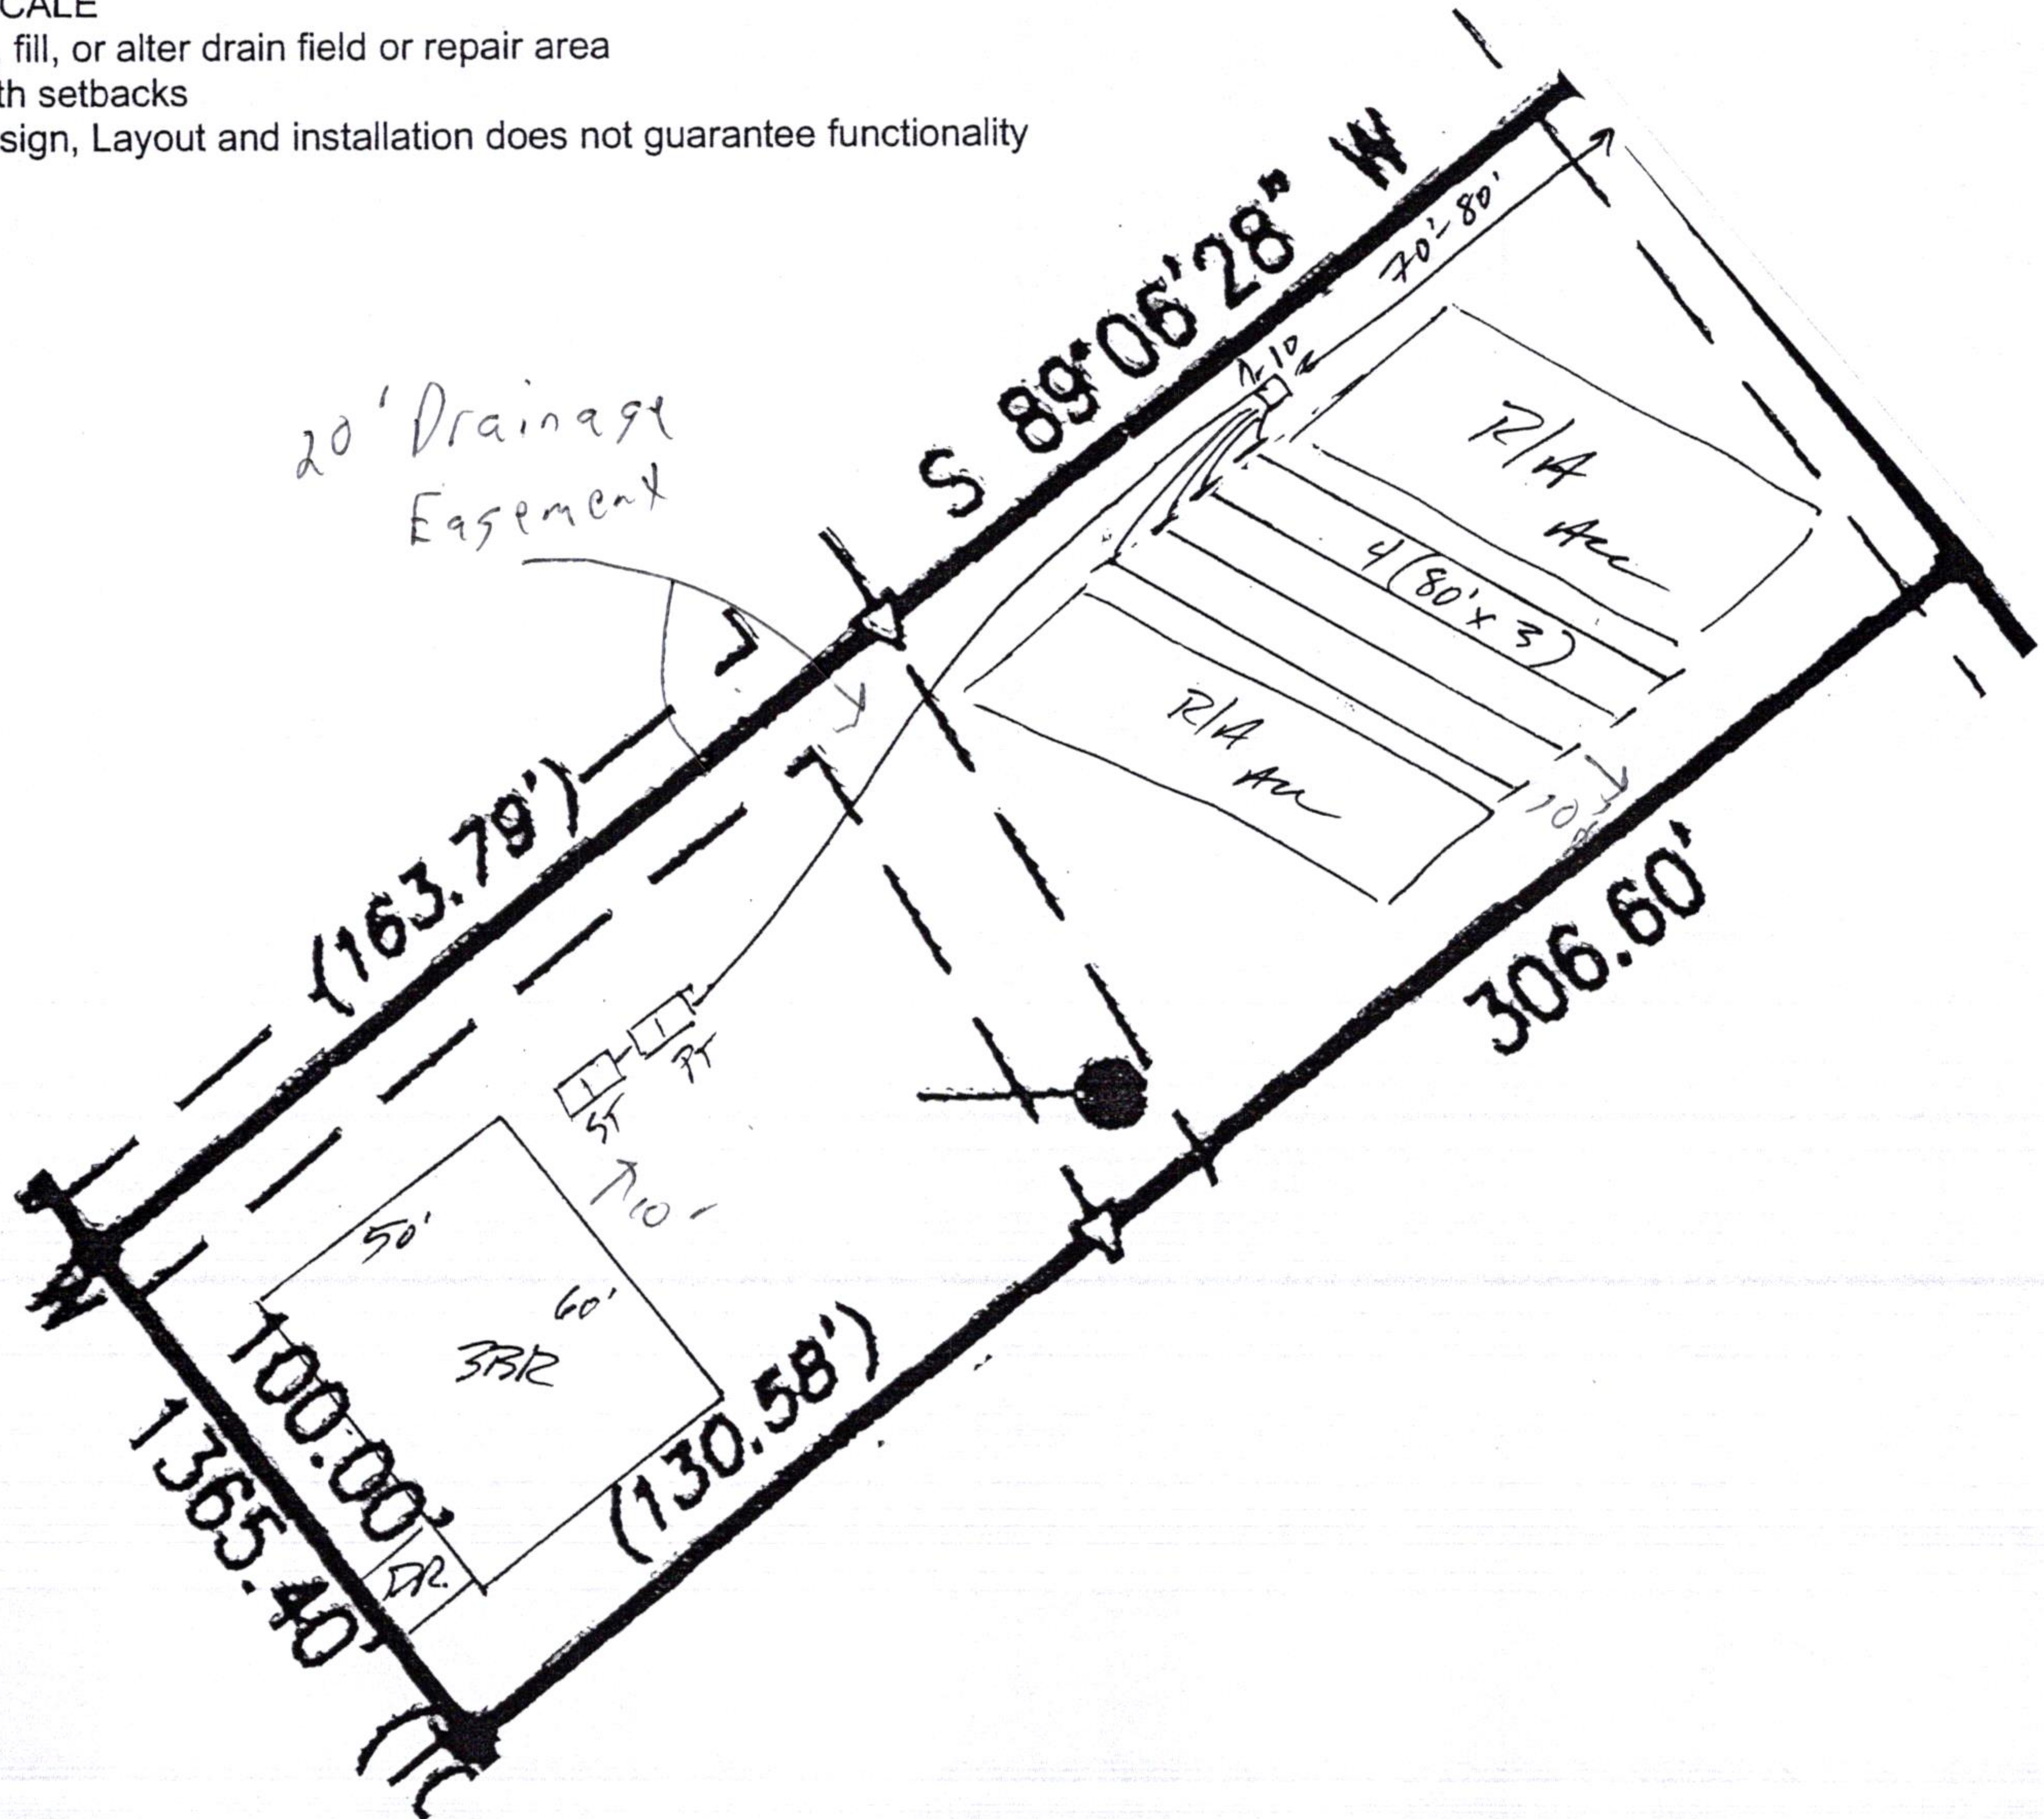

Document Details

Title	204624.pdf
File Name	204624.pdf
Document ID	80f72464d57249a58696687641326cc3
Fingerprint	19a951c7cec0a943d588e5e2dbd0137d
Status	Completed

Document History

Document Created	Document Created by Alisa Daughtry (alisa.daughtry@johnstonnc.com) Fingerprint: 1ba25598223e17f05a809bad9b0a3fe6	Jan 03 2025 11:33AM America/New_York
Document Sent	Document Sent to DENNIS PEACOCK (DENNISPEACOCK@CAROLINACOMFORTAIR.COM)	Jan 03 2025 11:33AM America/New_York
Document Viewed	Document Viewed by DENNIS PEACOCK (DENNISPEACOCK@CAROLINACOMFORTAIR.COM) IP: 104.47.58.126	Jan 03 2025 12:43PM America/New_York
Document Viewed	Document Viewed by DENNIS PEACOCK (DENNISPEACOCK@CAROLINACOMFORTAIR.COM) IP: 96.10.23.202	Jan 03 2025 12:43PM America/New_York
Document Viewed	Document Viewed by DENNIS PEACOCK (DENNISPEACOCK@CAROLINACOMFORTAIR.COM) IP: 52.176.50.116	Jan 03 2025 12:43PM America/New_York
Document Signed	Document Signed by DENNIS PEACOCK (DENNISPEACOCK@CAROLINACOMFORTAIR.COM) IP: 96.10.23.202 DENNIS PEACOCK	Jan 03 2025 12:43PM America/New_York
Document Completed	This document has been completed. Fingerprint: 19a951c7cec0a943d588e5e2dbd0137d	Jan 03 2025 12:44PM America/New_York