

PITT COUNTY COMMUNITY HEALTH DEPARTMENT
1825 WEST SIXTH STREET
GREENVILLE, NORTH CAROLINA 27834

PITT COUNTY
HEALTH DEPARTMENT
Greenville, N. C.

CERTIFICATE OF COMPLETION

Ground Absorption Sewage Disposal System (Septic Tanks)
N. C. General Statutes Chapter 130 - Article 13C.

Date 1-21-74

Owner Wm Brubaker

Address Rt 9 Swell

No. Bedrooms 2 No. Figures None

No. Users _____ Garbage Disposal _____

Washing Machine _____

Tank Capacity 500 gal Mfg. Trask Material _____

Drain Lines _____ sq. ft. _____ No. lines _____ Width _____


Dist. Box installed _____ Depth of Sump _____

Water Supply _____ Ind. _____ Public _____

Installed by James L. Stechi

Permit No. 40-74-A

SKETCH OF LAYOUT

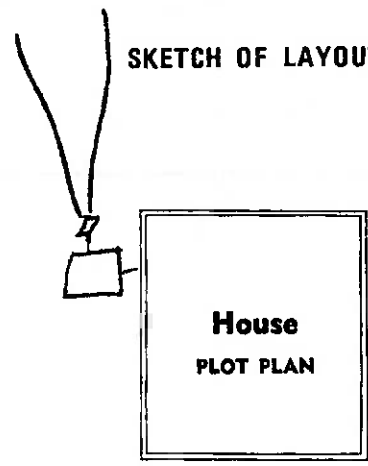

Have Tank and Drain Lines Inspected by a Representative of the Pitt County Health Department before covering.

By James L. Stechi
Sanitarian

This certificate does not imply any liability on the part of the Pitt County Community Health Department, only that the sewage disposal system was installed under the supervision of the Pitt County Community Health Department and with proper maintenance should give satisfactory service.

cod