Pine Forest Cut.
King, Herschel + Jackie
Map Block Lot 11

CHATHAM COUNTY HEALTH DEPARTMENT

Water Supply and Sewage Disposal

IMPROVEMENTS PERMIT

No. VR-2910A

Date 5/16/14

Owner: Hoskins + Nicholas

Location: Ring Forest Court Lot #11

Contractor:

Water Supply: Private ____ Public ✓

No. Bedrooms 3 Other ____

Daily Flow Rate ____ Application Rate ____

PERMIT to INSTALL SEPTIC SYSTEM FOR NEW CONSTRUCTION OF HOUSE

Size of tank: 1000 gal ✓ Nitrification line: 400 x ? in contour w/ max trench depth of 24-30"

Water supply and sewage disposal facilities location, installation and protection must meet state and local regulations. maintain in 5 years

Septic tank should be pumped out every 3 to 5 years and shall be maintained by owner in such a manner as not to create a public health hazard. Septic tank and nitrification line MUST BE INSPECTED AND APPROVED BY A MEMBER OF THE HEALTH DEPARTMENT STAFF BEFORE ANY PORTION OF THE INSTALLATION IS COVERED AND PUT INTO USE.

Signed Virginia Ryan R.S.
Sanitarian

Counter-signed ____
(Owner or his representative)

This permit is subject to revocation if site plans or the intended use change. This permit for sewage disposal is valid for 5 years.

Certificate of Completion

Date Approved: 8/10/14 By: Virginia Ryan R.S.
Sanitarian

(OVER)

Location of well and sewage disposal facilities sketched on back.

B&E 10/89

NOTE: Make sketch of installation showing lot size and shape, location of house, septic tanks, privies, water supplies, etc. Note special problems existing on lot. Write in measurements in order that installations may be located at later date. Note location of water supplies on adjacent lots.
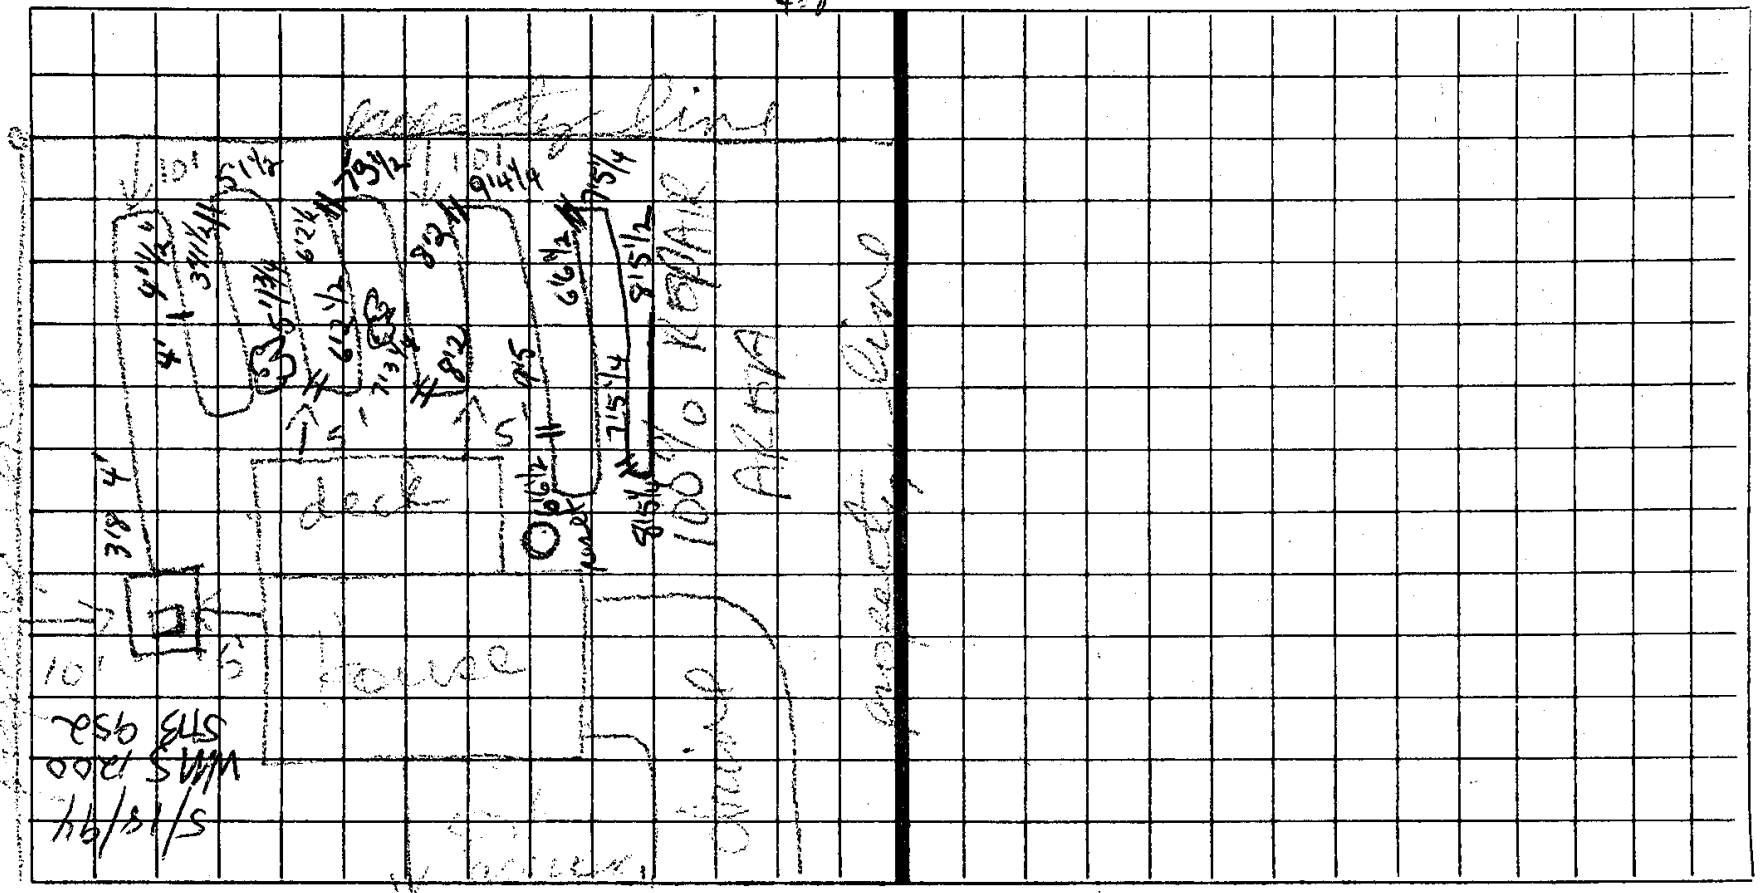
(1) (2)